

**MARSHALL**  
**P 2029**  
**6-19-79**

MISSISSIPPI  
 BOARD OF WATER COMMISSIONERS  
 416 North State Street  
 Jackson, Mississippi 39201

WATER WELL DRILLERS LOG

6-19-79 date well completed  
 Dent Kent Bump firm name  
 Marshall county well located

LANDOWNER: Lewis Clark  
 Holly Springs, Miss.  
 (mailing address)

description of formations encountered	from	to
Clay	0	20
Sand	20	155

WELL LOCATION:  
 sec. 26 T 4 N R 2 E  
 2 miles north of Lake Center  
 (distance) (direction) (nearest town)

Clay	155	165
Sand	165	190

WELL PURPOSE: Irrigation  
 (home, irrigation, municipal, industrial)

WELL COMPLETION DATA:

- (1) diameter (inches) 4"
- (2) total depth (feet) 190 feet
- (3) static water level (feet) 140 below top of ground.
- (4) casing PVC 190 feet (material) (depth)
- (size) If telescope see back.
- (5) screen 24' 183 feet (length) (depth to top)
- 4" Gravel wall (size) (material)
- (6) pump 3/4 14 (HP) (yield gpm)
- (type power)
- (7) electric log elect. (yes or no)
- (organization running log)
- (8) how well bottom plugged 4' clay.

DRILLERS REMARKS:


Miss. Board of Water Comm

JUL 5 1979

RECEIVED

If well telescopes please sketch and show depths.

GROUND LEVEL

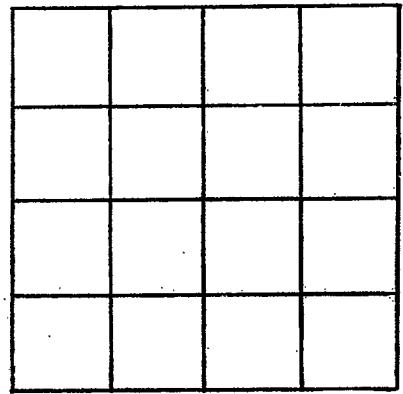

SECTION \_\_\_\_\_

Please indicate well location X.

ADDITIONAL INFORMATION

A series of horizontal lines for entering additional information, starting below the 'ADDITIONAL INFORMATION' header and extending to the bottom of the page.

If more than one screen, show locations of each on sketch.