

MARSHALL
P 2030
6-21-79

MISSISSIPPI
 BOARD OF WATER COMMISSIONERS
 416 North State Street
 Jackson, Mississippi 39201

WATER WELL DRILLERS LOG

6-21 1979 Demoffert Bros well Marshall
 date well completed firm name county well located

LANDOWNER:	description of formations encountered	from	to
<u>Swatie Brown</u>			
<u>Holly Springs, Miss</u> (mailing address)	<u>Sand</u>	<u>20</u>	<u>130</u>
WELL LOCATION:			
sec. <u>26</u> T <u>4</u> N R <u>2</u> E <u>3</u> miles <u>North</u> of <u>Lake Center</u> (distance) (direction) (nearest town)			
WELL PURPOSE: <u>Drinking</u> (home, irrigation, municipal, industrial)			
WELL COMPLETION DATA:			
(1) diameter (inches) <u>4"</u>			
(2) total depth (feet) <u>130 feet</u>			
(3) static water level (feet) <u>90 feet</u> <u>below</u> / <u>above</u> top of ground.			
(4) casing <u>PVC</u> <u>130 feet</u> (material) (depth)			
(size) if telescope see back.			
(5) screen <u>7 ft.</u> <u>123 feet</u> (length) (depth to top)			
<u>4"</u> <u>Gravel well</u> (size) (material)			
(6) pump <u>3/4</u> <u>14</u> (HP) (yield gpm)			
(type power)			
(7) electric log <u>Yes</u> (yes or no)			
(organization running log)			
(8) how well bottom plugged <u>4" of</u>			
DRILLERS REMARKS:			


Miss. Board of Water Comm.

JUL 5 1979

RECEIVED

If well telescopes please sketch and show depths.

GROUND LEVEL

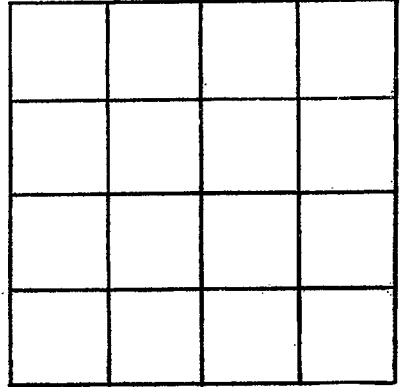

SECTION _____

Please indicate well location X.

ADDITIONAL INFORMATION

If more than one screen, show locations of each on sketch.