

MARSHALL
P
7-11-79
2033
7-11

MISSISSIPPI  
 BOARD OF WATER COMMISSIONERS  
 416 North State Street  
 Jackson, Mississippi 39201

WATER WELL DRILLERS LOG

date well completed 7-11-79 firm name Dempsey Brothers Well Marshall county well located Marshall

LANDOWNER:	description of formations encountered	from	to
<u>Billy Curtis</u>			
<u>Holly Springs</u> (mailing address)	<u>clay</u>	<u>60</u>	<u>80</u>
	<u>sand</u>	<u>80</u>	<u>150</u>
WELL LOCATION: sec. <u>10</u> T <u>4</u> N R <u>2</u> E <u>4</u> miles <u>West</u> of <u>Holly Springs</u> (distance) (direction) (nearest town)			
WELL PURPOSE: <u>Dwelling</u> (home, irrigation, municipal, industrial)			
WELL COMPLETION DATA:			
(1) diameter (inches)	<u>4"</u>		
(2) total depth (feet)	<u>150 feet</u>		
(3) static water level (feet)	<u>60</u> below top of ground.		
(4) casing (material)	<u>PVC</u>		
(4) casing (depth)	<u>150 feet</u>		
(4) casing (size)	if telescope see back.		
(5) screen (length)	<u>74 ft.</u>		
(5) screen (depth to top)	<u>143 feet</u>		
(6) pump (size)	<u>4"</u>		
(6) pump (material)	<u>gravel wail</u>		
(6) pump (HP)	<u>3/4</u>		
(6) pump (yield gpm)	<u>14</u>		
(7) electric log (yes or no)	<u>no</u>		
(8) how well bottom plugged	<u>4" cap.</u>		

Miss. Board of Water Comm.


AUG 8 1979

RECEIVED

DRILLERS REMARKS:

If well telescopes please sketch and show depths.

GROUND LEVEL

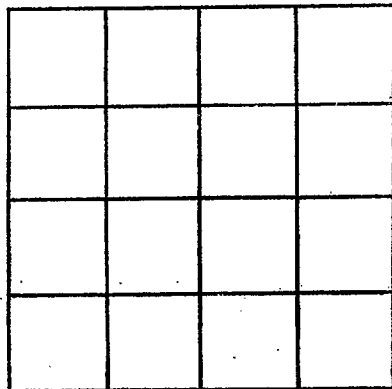

SECTION \_\_\_\_\_

Please indicate well location X.

ADDITIONAL INFORMATION

If more than one screen,  
show locations of each on sketch.