

MARSHALL
P
8/17/79
2034

MISSISSIPPI
BOARD OF WATER COMMISSIONERS
416 North State Street
Jackson, Mississippi 39201
WATER WELL DRILLERS LOG

8-17 19 79 Hick Wood Marshall
date well completed firm name county well located

LANDOWNER: Orlando Crane

description of formations encountered

description of formations encountered	from	to
<u>Clay</u>	<u>0</u>	<u>30</u>
<u>Red sand</u>	<u>30</u>	<u>100</u>
<u>white sand</u>	<u>100</u>	<u>245</u>

Be. 1 Holly Springs (mailing address)

WELL LOCATION:
sec. 11 T 4 N R 2 E
(S) (W)
4 miles S-E of Holly Springs
(distance) (direction) (nearest town)

WELL PURPOSE: None
(home, irrigation, municipal, industrial)

WELL COMPLETION DATA:

(1) diameter (inches) 4 in

(2) total depth (feet) 245

(3) static water level (feet) _____ below/above top of ground.

(4) casing Plastic, 245
(material) (depth)

_____ if telescope see back.
(size)

(5) screen 7 ft, 238
(length) (depth to top)

4 in., galvanized
(size) (material)

(6) pump 1/2, 10
(HP) (yield gpm)

220
(type power)

(7) electric log No
(yes or no)

_____ (organization running log)

(8) how well bottom plugged cap


Miss. Board of Water Comm.

AUG 29 1979
RECEIVED

DRILLERS REMARKS:

If well telescopes please sketch and show depths.

GROUND LEVEL

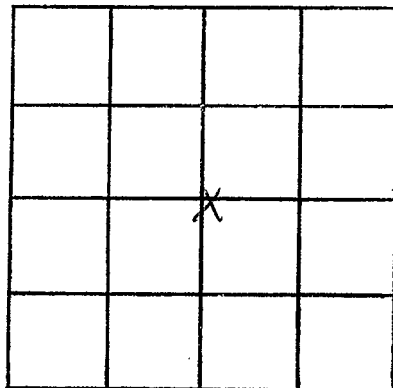

SECTION 11

Please indicate well location X.

ADDITIONAL INFORMATION

If more than one screen,
show locations of each on sketch.