

Marshall
P
7-21-79
2036

MISSISSIPPI
BOARD OF WATER COMMISSIONERS
416 North State Street
Jackson, Mississippi 39201

WATER WELL DRILLERS LOG

7-21-1979 date well completed Robert W. Wilton firm name Marshall county well located

LANDOWNER:	description of formations encountered	from	to
John McKeown	Red clay + pink sand	0	30
Box #1 Holly Springs Miss. (mailing address)	Red sand	30	105
	White clay	105	120
	White sand	120	150
WELL LOCATION:			
sec <u>33</u> <u>T</u> <u>4</u> <u>N</u> R- <u>2</u> <u>E</u> <u>W</u>			
_____ miles _____ of _____ (distance) (direction) (nearest town)			
WELL PURPOSE: (home, irrigation, municipal, industrial)			
WELL COMPLETION DATA:			
(1) diameter (inches) <u>4</u>			
(2) total depth (feet) <u>147</u>			
(3) static water level (feet) <u>130</u> below above top of ground.			
(4) casing _____, _____, _____ (material) (depth)			
_____ If telescope see back. (size)			
(5) screen <u>20</u> , _____ (length) (depth to top)			
_____ , _____ (size) (material)			
(6) pump <u>3/4</u> , _____ (HP) (yield gpm)			
<u>electric</u> (type power)			
(7) electric log _____ (yes or no)			
_____ (organization running log)			
(8) how well bottom plugged <u>4"</u> <u>plastic cap</u>			
DRILLERS REMARKS:			


Miss. Board of Water Comm.

SEP 20 1979

RECEIVED

If well telescopes please sketch and show depths.

GROUND LEVEL

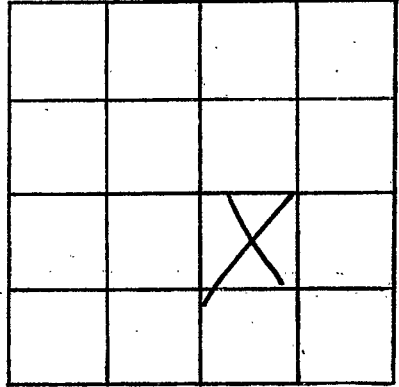

SECTION 33

Please indicate well location X.

ADDITIONAL INFORMATION

If more than one screen,
show locations of each on sketch.