

Marshall
P 2039
12-4-79

MISSISSIPPI
 BOARD OF WATER COMMISSIONERS
 416 North State Street
 Jackson, Mississippi 39201

WATER WELL DRILLERS LOG

12-4-79 1979 Frank Rich Woods Marshall
 date well completed firm name county well located

LANDOWNER:
Curtis Jefferson
Rt. 1, 2645 Springs
 (mailing address)

description of formations encountered	from	to
<u>red clay</u>	<u>0</u>	<u>20</u>
<u>white sand</u>	<u>20</u>	<u>80</u>
<u>Black clay</u>	<u>80</u>	<u>140</u>

WELL LOCATION:
 sec. 26 T 4 N R 2 E
1 miles W of Watts
 (distance) (direction) (nearest town)

WELL PURPOSE: Home
 (home, irrigation, municipal, industrial)

WELL COMPLETION DATA:
 (1) diameter (inches) 4.0
 (2) total depth (feet) 140
 (3) static water level (feet) 80 below top of ground.
 (4) casing Plastic 140
 (material) (depth)
 (size) if telescope see back.
 (5) screen 2ft 133
 (length) (depth to top)
1/2 in gravel
 (size) (material)
 (6) pump 1/2 10
 (HP) (yield gpm)
220
 (type power)
 (7) electric log No
 (yes or no)
 (organization running log)
 (8) how well bottom plugged Cap

DEPT. OF NATURAL RESOURCES
 BUREAU OF LAND & WATER RESOURCES


DEC 10 1979

RECEIVED

DRILLERS REMARKS:

If well telescopes please
sketch and show depths.

GROUND LEVEL

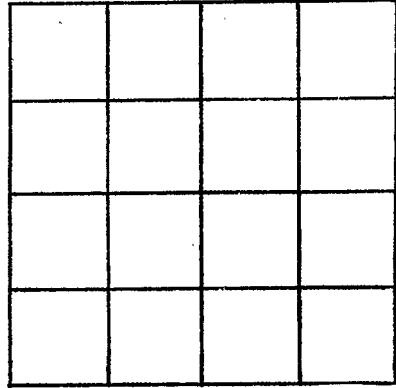

SECTION _____

Please indicate well location X.

ADDITIONAL INFORMATION

If more than one screen,
show locations of each on sketch.