

Marshall

MISSISSIPPI  
BOARD OF WATER COMMISSIONERS  
416 North State Street  
Jackson, Mississippi 39201

P 2040

6-5-80

6-5

WATER WELL DRILLERS LOG

1980 Hicks Wells Marshall  
date well completed firm name county well located

LANDOWNER:  
Ruth Woods  
Tolly Springs  
(mailing address)

description of formations encountered	from	to
clay	0	30
red sand	30	90
white sand	90	147

WELL LOCATION:  
sec. 7 T 4 N R 2 E  
3 miles 05 of Tolly Springs  
(distance) (direction) (nearest town)

WELL PURPOSE: home  
(home, irrigation, municipal, industrial)

WELL COMPLETION DATA:

(1) diameter (inches) 4 in

(2) total depth (feet) 147

(3) static water level (feet) 120 above top of ground.

(4) casing Plastic 1 1/2" (material) (depth)

(size) if telescope see back.

(5) screen 7 ft 140 (length) (depth to top)  
4 in Gravel (size) (material)

(6) pump 1/2 10 (HP) (yield gpm)  
220 (type power)

(7) electric log No (yes or no)

(organization running log)

(8) how well bottom plugged Cap

DRILLERS REMARKS:


DEPT. OF NATURAL RESOURCES  
BUREAU OF LAND & WATER RESOURCES

JUN 25 1980

RECEIVED

If well telescopes please sketch and show depths.

GROUND LEVEL

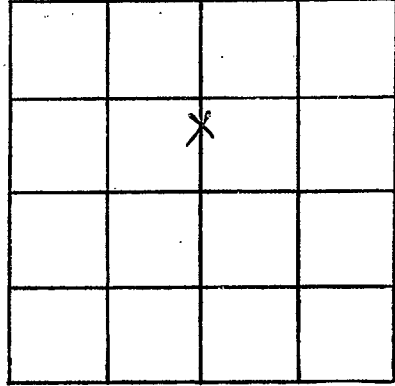

SECTION 7

Please indicate well location X.

ADDITIONAL INFORMATION

If more than one screen, show locations of each on sketch.