

MISSISSIPPI DEPARTMENT OF NATURAL RESOURCES

Bureau of Land and Water Resources

Southport Mall

P.O. Box 10631

Jackson, Mississippi 39209

WATER WELL DRILLERS LOG

Marshall
P 2041
7/80

7-1-1980 date well completed Wilson Well Co firm name Marshall county well located

LANDOWNER:
 Dr. Eugene Williams
 Holly Springs
 P.O. Box 337
 (mailing address)

description of formations encountered	from	to
Red clay + Red Sand	6	30
White clay + Red Sand	30	60
Red Sand	60	105
Red Sand, white clay - top	105	135
white clay	135	195
white clay, white sand	195	210
White Sand	210	260

WELL LOCATION:
 sec. B T 4 N R 2 E
 7 miles East of Holly Springs
 (distance) (direction) (nearest town)

WELL PURPOSE:
 (home, irrigation, municipal, industrial)

WELL COMPLETION DATA:

(1) diameter (inches) 4

(2) total depth (feet) 260

(3) static water level (feet) 200 below top of ground.

(4) casing PVC 140 (material) (depth) if telescope see back.

(5) screen 10 250 (length) (depth to top)

(6) pump 3/4 10 (HP) (yield gpm) gravel packed (size) (material)

(7) electric log (type power) (yes or no)

(8) how well bottom plugged 4" plastic cap

DRILLERS REMARKS:


DEPT. OF NATURAL RESOURCES
 BUREAU OF LAND & WATER RESOURCES

SEP 29 1980

RECEIVED

If well telescopes please sketch and show depths.

GROUND LEVEL

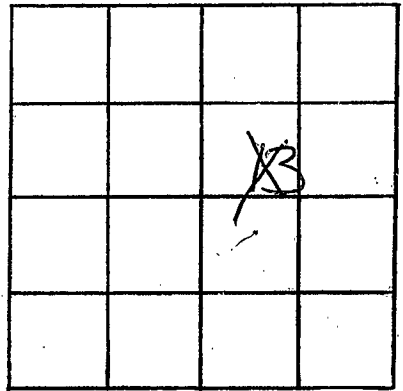

SECTION 13

Please indicate well location X.

ADDITIONAL INFORMATION

If more than one screen,
show locations of each on sketch.