

Marshall  
 P 2042  
 7-16-80

MISSISSIPPI  
 BOARD OF WATER COMMISSIONERS  
 416 North State Street  
 Jackson, Mississippi 39201

WATER WELL DRILLERS LOG

7-16-80 date well completed      Hanks Well Co firm name      Marshall county well located

LANDOWNER: <u>Catherine Palmer</u>	description of formations encountered	from	to
<u>Holly Springs, Mo.</u>			
(mailing address)	<u>Red Clay</u>	<u>0</u>	<u>20</u>
	<u>White Sand</u>	<u>20</u>	<u>200</u>

WELL LOCATION:  
 sec. 23 T 4 N R. 2 E  
2 miles NW of Lake Center  
 (distance) (direction) (nearest town)

WELL PURPOSE: Home  
 (home, irrigation, municipal, industrial)

- WELL COMPLETION DATA:
- (1) diameter (inches) 4
  - (2) total depth (feet) 200
  - (3) static water level (feet) 15 below top of ground.
  - (4) casing PVC, 200,  
 (material) (depth)  
 (size) if telescope see back.
  - (5) screen 7', 193  
 (length) (depth to top)  
4", gravel type  
 (size) (material)
  - (6) pump 1/2 10  
 (HP) (yield gpm)  
220V  
 (type power)
  - (7) electric log No  
 (yes or no)  
 (organization running log)
  - (8) how well bottom plugged Cap

DRILLERS REMARKS:


DEPT. OF NATURAL RESOURCES  
 BUREAU OF LAND & WATER RESOURCES

SEP 26 1980

RECEIVED

If well telescopes please sketch and show depths.

GROUND LEVEL

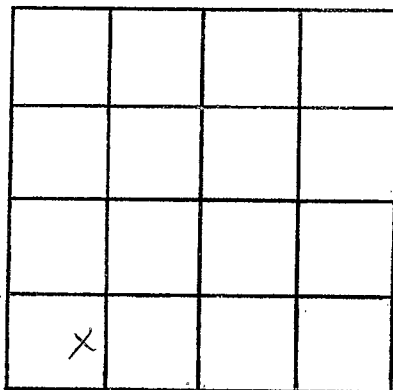

SECTION 23

Please indicate well location X.

ADDITIONAL INFORMATION

If more than one screen,  
show locations of each on sketch.