

**MARSHALL**  
**P 2044**  
**8-1-80**

MISSISSIPPI  
 BOARD OF WATER COMMISSIONERS  
 416 North State Street  
 Jackson, Mississippi 39201

WATER WELL DRILLERS LOG

8-1-80 date well completed      Hicks Well Co. firm name      Marshall county well located

LANDOWNER: <u>Othel McBlaine</u>	description of formations encountered	from	to
<u>Ret. / Holly Springs, Mo.</u> (mailing address)			
<u>Ret. / Holly Springs, Mo.</u> (mailing address)	<u>Clay</u>	<u>0</u>	<u>30</u>
<u>23</u> miles <u>NW</u> of <u>Super Center</u> (distance) (direction) (nearest town)	<u>Sand</u>	<u>30</u>	<u>120</u>
<u>23</u> miles <u>NW</u> of <u>Super Center</u> (distance) (direction) (nearest town)	<u>White Sand</u>	<u>120</u>	<u>140</u>
<b>WELL LOCATION:</b> sec. <u>16</u> T <u>4</u> N R <u>2</u> E <u>23</u> miles <u>NW</u> of <u>Super Center</u> (distance) (direction) (nearest town)			
<b>WELL PURPOSE:</b> <u>Home</u> (home, irrigation, municipal, industrial)			
<b>WELL COMPLETION DATA:</b>			
(1) diameter (inches) <u>4</u>			
(2) total depth (feet) <u>140</u>			
(3) static water level (feet) <u>100</u> below above top of ground.			
(4) casing <u>PVC</u> <u>140</u> (material) (depth)			
<u>        </u> if telescope see back. (size)			
(5) screen <u>7</u> <u>133</u> (length) (depth to top)			
<u>4"</u> <u>Galval Type</u> (size) (material)			
(6) pump <u>1/2</u> <u>10</u> (HP) (yield gpm)			
<u>220V</u> (type power)			
(7) electric log <u>No</u> (yes or no)			
<u>        </u> (organization running log)			
(8) how well bottom plugged <u>Cap</u>			

DRILLERS REMARKS:


DEPT. OF NATURAL RESOURCES  
 BUREAU OF LAND & WATER RESOURCES

SEP 26 1980

RECEIVED

If well telescopes please sketch and show depths.

GROUND LEVEL

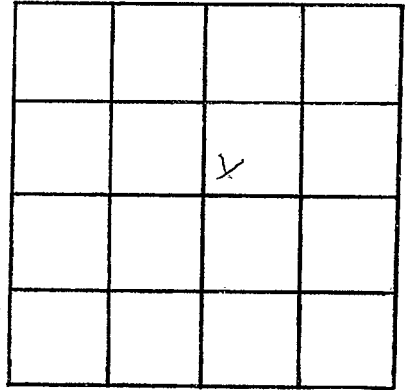

SECTION 16

Please indicate well location X.

ADDITIONAL INFORMATION

If more than one screen,  
show locations of each on sketch.