

MISSISSIPPI DEPARTMENT OF NATURAL RESOURCES
Bureau of Land and Water Resources
 Southport Mall
 P.O. Box 10631
 Jackson, Mississippi 39209
WATER WELL DRILLERS LOG

Marshall
P 2046
11-10-80

11-10 1980 Hicks Well Co. Marshall
 date well completed firm name county well located

LANDOWNER: Clyde Coate
Rt. 5
Holly Springs, Ms.
 (mailing address)
 WELL LOCATION:
 sec. 23 T. 4 N. R. 2 E.
3 miles SE of Holly Springs
 (distance) (direction) (nearest town)

| description of formations encountered | from | to |
|---------------------------------------|------------|------------|
| <u>Red clay</u> | <u>0</u> | <u>20</u> |
| <u>CO₂ + sand</u> | <u>20</u> | <u>120</u> |
| <u>white clay</u> | <u>120</u> | <u>170</u> |
| <u>white sand</u> | <u>170</u> | <u>245</u> |

WELL PURPOSE: Home
 (home, irrigation, municipal, industrial)


- WELL COMPLETION DATA:
- (1) diameter (inches) 4
 - (2) total depth (feet) 245
 - (3) static water level (feet) 160 below top of ground.
 - (4) casing PVC, 245,
 (material) (depth)
 (size) if telescope see back.
 - (5) screen 12, 233
 (length) (depth to top)
4", gravel + slotted
 (size) (material)
 - (6) pump 3/4, 10
 (HP) (yield gpm)
220V
 (type power)
 - (7) electric log No
 (yes or no)
 (organization running log)
 - (8) how well bottom plugged Cap

DRILLERS REMARKS:

DEPT. OF NATURAL RESOURCES
 BUREAU OF LAND & WATER RESOURCES
 DEC - 3 1980
RECEIVED

If well telescopes please sketch and show depths.

GROUND LEVEL

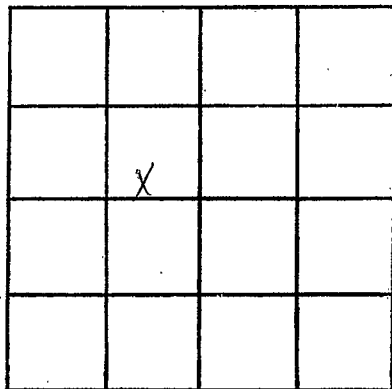

SECTION 23

Please indicate well location X.

ADDITIONAL INFORMATION

If more than one screen,
show locations of each on sketch.