

MARSHALL
 P 2047
 10-15-80

MISSISSIPPI
 BOARD OF WATER COMMISSIONERS
 416 North State Street
 Jackson, Mississippi 39201
 WATER WELL DRILLERS LOG

10-15-19 80 Wilson Wells Marshall
 date well completed firm name county well located

LANDOWNER:
 Robert S. Depton
 Rt 2 Potts Camp Miss
 (mailing address)

description of formations encountered	from	to
Red clay & Red Sand	0	30
Red Sand	30	105
White clay Brown Sand	105	120
Blue Sand	120	150

WELL LOCATION:
 sec. 25 T-4 N R-2 E
 6 1/2 miles E of Holly Springs
 (distance) (direction) (nearest town)

WELL PURPOSE:
 (home, irrigation, municipal, industrial)

WELL COMPLETION DATA:
 (1) diameter (inches) 4
 (2) total depth (feet) 150
 (3) static water level (feet) _____ below above top of ground.
 (4) casing Plastic (material), 150 (depth), 4" (size) if telescope see back.
 (5) screen 10 (length), 140 (depth to top), 4" (size), gravel packed (material)
 (6) pump _____ (HP), _____ (yield gpm), electric (type power)
 (7) electric log NO (yes or no)
 _____ (organization running log)

(8) how well bottom plugged H" plastic cap


DRILLERS REMARKS:

DEPT. OF NATURAL RESOURCES
 BUREAU OF LAND & WATER RESOURCES

DEC 18 1980
 RECEIVED

If well telescopes please sketch and show depths.

GROUND LEVEL

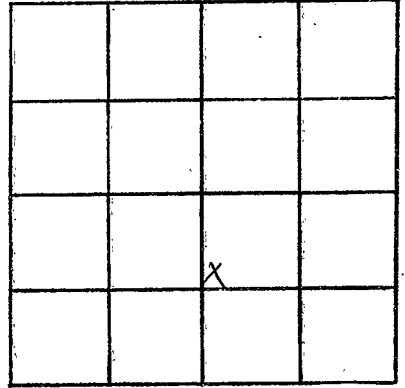

SECTION 20

Please indicate well location X.

ADDITIONAL INFORMATION

If more than one screen,
show locations of each on sketch.