

Marshall
 P 7048
 11-3-80

MISSISSIPPI
 BOARD OF WATER COMMISSIONERS
 416 North State Street
 Jackson, Mississippi 39201

WATER WELL DRILLERS LOG

Marshall


11-3-1980 date well completed
 Wilson Well Co, Inc firm name
 Marshall county well located

LANDOWNER:	description of formations encountered	from	to
Wallace & G. Howell Rt 1 Box 264A Tusculum, TN 37674 (mailing address)	Red clay Red Sand	0	30
	Red Sand Rock	30	60
	Blue clay	60	105
	Blue clay Green Sand	105	130
	Green Sand + Rock	120	135
	Green Sand + Rock	135	155
WELL LOCATION: sec. <u>25</u> T <u>4</u> N R <u>2</u> E (S) (W) 1 miles N of Lake Center (distance) (direction) (nearest town)			
WELL PURPOSE: (home, irrigation, municipal, industrial)			
WELL COMPLETION DATA:			
(1) diameter (inches) <u>4</u>			
(2) total depth (feet) <u>152</u>			
(3) static water level (feet) <u>125</u> below top of ground.			
(4) casing (material) (depth) (size) if telescope see back.			
(5) screen <u>20</u> <u>132</u> (length) (depth to top)			
(6) pump <u>4</u> <u>gravel</u> (size) (material)			
(7) pump <u>2</u> (HP) (yield gpm)			
(8) electric (type power)			
(7) electric log (yes or no)			
(organization running log)			
(8) how well bottom plugged <u>4/11</u> <u>plaster clay</u>			
DRILLERS REMARKS:			

DEPT. OF NATURAL RESOURCES
 BUREAU OF LAND & WATER RESOURCES
 DEC 13 1980
 RECEIVED

If well telescopes please sketch and show depths.

GROUND LEVEL

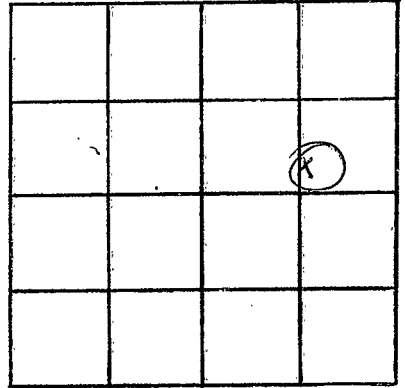

SECTION 25

Please indicate well location X.

ADDITIONAL INFORMATION

If more than one screen,
show locations of each on sketch.