

MISSISSIPPI DEPARTMENT OF NATURAL RESOURCES

Bureau of Land and Water Resources

Southport Mall

P.O. Box 10631

Jackson, Mississippi 39209

WATER WELL DRILLERS LOG

Marshall  
7 2049  
12-11-80

12-11 1980 Hick Well Co. Marshall  
 date well completed firm name county well located

LANDOWNER: Cleveland Wilkins  
P.O. Box 752

description of formations encountered	from	to
	<u>Clay + sand</u>	<u>0</u>
<u>white sand</u>	<u>30</u>	<u>225</u>

Holly Springs, MS.  
 (mailing address)

WELL LOCATION:  
 sec. 24 T. 4 N. R. 2 E. W. 5  
5 miles SE of Holly Springs  
 (distance) (direction) (nearest town)

WELL PURPOSE: Home  
 (home, irrigation, municipal, industrial)

WELL COMPLETION DATA:


- (1) diameter (inches) 4
- (2) total depth (feet) 225
- (3) static water level (feet) 175 Below above top of ground.
- (4) casing PVC 225  
 (material) (depth)  
 (size) if telescope see back.
- (5) screen 17 212  
 (length) (depth to top)  
02 gravel type  
 (size) (material)
- (6) pump 3/4 10  
 (HP) (yield gpm)  
220V  
 (type power)
- (7) electric log No  
 (yes or no)  
 (organization running log)
- (8) how well bottom plugged Cap

DRILLERS REMARKS:

DEPT. OF NATURAL RESOURCES  
 BUREAU OF LAND & WATER RESOURCES  
 RECEIVED  
 DEC 23 1980

If well telescopes please  
sketch and show depths.

GROUND LEVEL

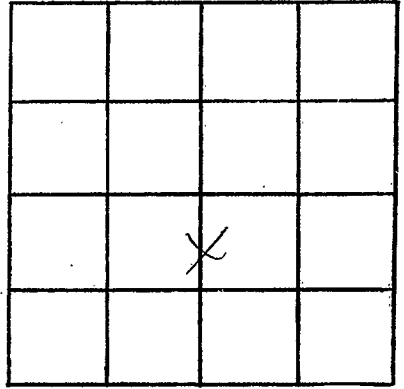

SECTION 04

Please indicate well location X.

ADDITIONAL INFORMATION

If more than one screen,  
show locations of each on sketch.