

MISSISSIPPI DEPARTMENT OF NATURAL RESOURCES

Bureau of Land and Water Resources

Southport Mall

P.O. Box 10631

Jackson, Mississippi 39209

WATER WELL DRILLERS LOG

MARSHALL
P 2050
12-23-80

12-23 1980 Hick Well Co. Marshall
 date well completed firm name county well located

LANDOWNER: Lincoln Lewis
Lake Center
Holly Springs
 (mailing address)
 WELL LOCATION:
 sec. 23 T 4 N R 2 E
2 miles W of Lake Center
 (distance) (direction) (nearest town)

description of formations encountered	from	to
<u>Red Sand</u>	<u>0</u>	<u>65</u>
<u>Red Sand + White Sand</u>	<u>65</u>	<u>125</u>
<u>White Sand</u>	<u>125</u>	<u>152</u>

WELL PURPOSE: Flow
 (home, irrigation, municipal, industrial)

WELL COMPLETION DATA:
 (1) diameter (inches) 4
 (2) total depth (feet) 152
 (3) static water level (feet) 180 below above top of ground.
 (4) casing PVC 152
 (material) (depth)
 (size) if telescope see back.
 (5) screen 7 145
 (length) (depth to top)
02 gravel tube
 (size) (material)
 (6) pump 1/2 10
 (HP) (yield gpm)
220V
 (type power)
 (7) electric log No
 (yes or no)
 (organization running log) Cap
 (8) how well bottom plugged

DRILLERS REMARKS:


DEPT. OF NATURAL RESOURCES
 BUREAU OF LAND & WATER RESOURCES

JAN 12 1991

RECEIVED

If well telescopes please
sketch and show depths.

GROUND LEVEL

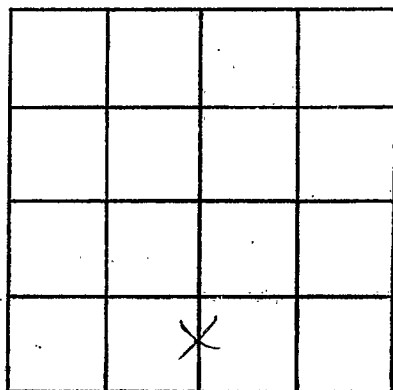

SECTION 23

Please indicate well location X.

ADDITIONAL INFORMATION

If more than one screen,
show locations of each on sketch.