

MISSISSIPPI DEPARTMENT OF NATURAL RESOURCES
Bureau of Land and Water Resources
 Southport Mall
 P.O. Box 10631
 Jackson, Mississippi 39209
WATER WELL DRILLERS LOG

Marshall
P 2051
12-30-80

date well completed 12-30 1980 firm name Hickwell Co. county well located Marshall

LANDOWNER: <u>Louise Alston</u>	description of formations encountered	from	to
---------------------------------	---------------------------------------	------	----

Holly Springs, Ms.
 ↓ ↓ (mailing address)

WELL LOCATION:
 sec. 18 T 4 N R 2 E
1/2 miles S of Holly Springs
 (distance) (direction) (nearest town)

WELL PURPOSE: drinking
 (home, irrigation, municipal, industrial)

WELL COMPLETION DATA:

- (1) diameter (inches) 4
- (2) total depth (feet) 170
- (3) static water level (feet) 170 below above top of ground.
- (4) casing PVC, 170
 (material) (depth)
- (size) if telescope see back.
- (5) screen 12, 118
 (length) (depth to top)
- 02, 02
 (size) (material)
- (6) pump 1/2, 10
 (HP) (yield gpm)
- 220V
 (type power)
- (7) electric log No
 (yes or no)

(organization running log)

(8) how well bottom plugged Cap

DRILLERS REMARKS:

description of formations encountered	from	to
<u>Red Sand</u>	<u>0</u>	<u>65</u>
<u>Clay Sand</u>	<u>65</u>	<u>140</u>
<u>White Sand</u>	<u>140</u>	<u>170</u>


DEPT. OF NATURAL RESOURCES
 BUREAU OF LAND & WATER RESOURCES

JAN 12 1981

RECEIVED

If well telescopes please
sketch and show depths.

GROUND LEVEL

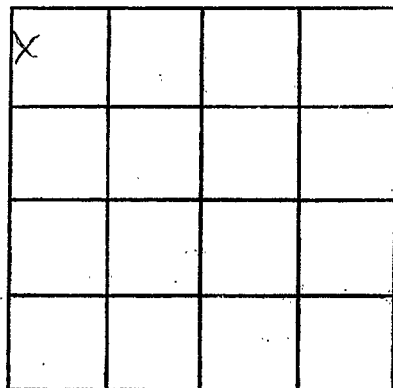

SECTION 18

Please indicate well location X.

ADDITIONAL INFORMATION

If more than one screen,
show locations of each on sketch.