

MARSHALL
P 2052

MISSISSIPPI
BOARD OF WATER COMMISSIONERS
416 North State Street
Jackson, Mississippi 39201

WATER WELL DRILLERS LOG

4/10/81

April 10 1981

date well completed

R. L. Carpenter

firm name

Marshall

county well located

LANDOWNER:

Lennie Bell

Potts Camp, Miss

R. F. D.

(mailing address)

description of formations
encountered

from

to

Surface Soil

0 19

Red
Med. ~~White~~ Sand

19 28

Med. White Sand

28 75

White. Fine Sand

75 98

White Clay

98 120

White Coarse Sand

120 155

WELL LOCATION:

sec 23 T 4 N R 2 E
S W

6 miles N.W. of Potts Camp
(distance) (direction) (nearest town)

WELL PURPOSE:

Domestic
(home, irrigation, municipal, industrial)


WELL COMPLETION DATA:

- (1) diameter (inches) 4
- (2) total depth (feet) 155
- (3) static water level (feet) 115 below top of ground.
- (4) casing PVC 145' (material) (depth)
(size) If telescope see back.
- (5) screen 10' 145' (length) (depth to top)
4" PVC (size) (material)
- (6) pump 1/2 9 (HP) (yield gpm)
Elevon (type power)
- (7) electric log no (yes or no)

(organization running log)


(8) how well bottom plugged PVC cap

DRILLERS REMARKS:

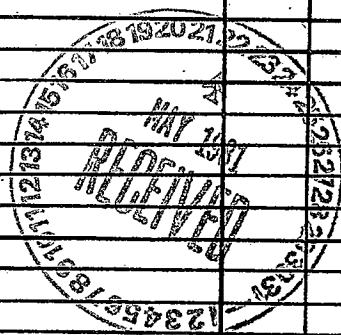

If well telescopes please sketch and show depths.

GROUND LEVEL

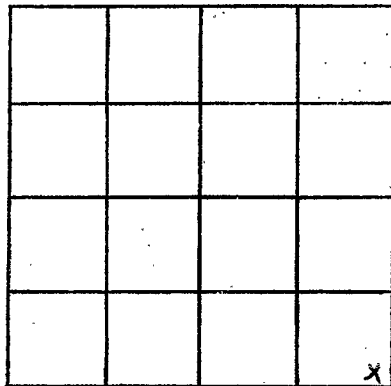

SECTION 23

Please indicate well location X.

ADDITIONAL INFORMATION

If more than one screen, show locations of each on sketch.