

MISSISSIPPI DEPARTMENT OF NATURAL RESOURCES

Bureau of Land and Water Resources

Southport Mall

P.O. Box 10631


Jackson, Mississippi 39209

WATER WELL DRILLERS LOG

MARSHALL  
P 2053  
6/2/81

1981 date well completed Don Kent Bumpnell firm name Marshall county well located


LANDOWNER:	description of formations encountered	from	to
<u>Katie Echols</u>		<u>Clay</u>	<u>0</u>
<u>Holly Springs, Miss</u> (mailing address)	<u>Sand</u>	<u>20</u>	<u>180</u>
WELL LOCATION:			
sec <u>23</u> <u>4</u> N R <u>2</u> E <div style="display: flex; justify-content: space-around; width: 100%;"> <span>(S)</span> <span>(W)</span> </div> <u>6</u> miles <u>S.E.</u> of <u>Holly Springs</u> (distance) (direction) (nearest town)			
WELL PURPOSE: <u>Drilling</u> (home, irrigation, municipal, industrial)			
WELL COMPLETION DATA:			
(1) diameter (inches) <u>4"</u>			
(2) total depth (feet) <u>180 feet</u>			
(3) static water level (feet) <u>127</u> below above top of ground.			
(4) casing <u>PVC</u> <u>180 feet</u> (material) (depth)			
_____ if telescope see back. (size)			
(5) screen <u>7 ft.</u> <u>173 feet</u> (length) (depth to top)			
<u>4"</u> <u>gravel wall</u> (size) (material)			
(6) pump <u>3/4</u> <u>14</u> (HP) (yield gpm)			
_____ (type power)			
(7) electric log <u>Est.</u> (yes or no)			
_____ (organization running log)			
(8) how well bottom plugged <u>4" cap</u>			

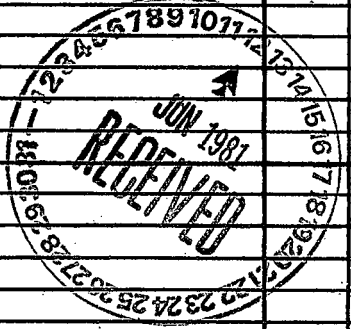

DRILLERS REMARKS:

If well telescopes please sketch and show depths.

GROUND LEVEL

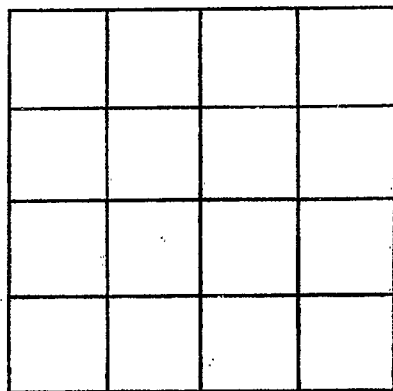

SECTION \_\_\_\_\_

Please indicate well location X.

ADDITIONAL INFORMATION

If more than one screen,  
show locations of each on sketch.