

MISSISSIPPI DEPARTMENT OF NATURAL RESOURCES

Bureau of Land and Water Resources

Southport Mall

P.O. Box 10631

Jackson, Mississippi 39209

WATER WELL DRILLERS LOG

MARSHALL
P 2054
11-4-81

11-4-81 date well completed Deartest Pumpwell firm name Marshall county well located


LANDOWNER:	description of formations encountered	from	to
Wesley Smith Holly Springs miss (mailing address)			
WELL LOCATION:			
sec. 26 4 N R 2 E (distance) miles (direction) of (nearest town)			
WELL PURPOSE: <u>Drinking</u> (home, irrigation, municipal, industrial)			
WELL COMPLETION DATA:			
(1) diameter (inches) <u>4"</u>			
(2) total depth (feet) <u>120 feet</u>			
(3) static water level (feet) <u>60</u> below above top of ground.			
(4) casing <u>PCC</u> <u>120 feet</u> (material) (depth)			
(size) if telescope see back.			
(5) screen <u>7 1/2'</u> <u>11.3 feet</u> (length) (depth to top)			
<u>4"</u> <u>gravel</u> (size) (material)			
(6) pump <u>3/4</u> <u>14</u> (HP) (yield/gpm)			
(type power)			
(7) electric log <u>Elcat</u> (yes or no)			
(organization running log)			
(8) how well bottom plugged <u>4" cap</u>			
DRILLERS REMARKS:			

DEPT. OF NATURAL RESOURCES
BUREAU OF LAND & WATER RESOURCES

NOV 16 1981
RECEIVED

If well telescopes please
sketch and show depths.

GROUND LEVEL

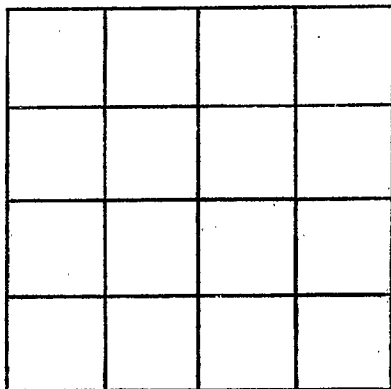

SECTION _____

Please indicate well location X.

ADDITIONAL INFORMATION

If more than one screen,
show locations of each on sketch.