

MISSISSIPPI DEPARTMENT OF NATURAL RESOURCES

Bureau of Land and Water Resources

Southport Mall

P.O. Box 10631

Jackson, Mississippi 39209

WATER WELL DRILLERS LOG

Marshall
P 2056
11-11-81

11-11 1981 HICKS WELL COMPANY Marshall  
 date well completed firm name county well located

LANDOWNER: <u>Reuby Taylor</u> <u>Rt. 5</u>	description of formations encountered	from	to
<u>Holly Springs, Mo.</u> (mailing address) <u>38635</u>			
<b>WELL LOCATION:</b> sec. <u>18</u> T. <u>4</u> N. R. <u>2</u> E <u>1/2</u> miles <u>S</u> of <u>Holly Springs</u> (distance) (direction) (nearest town)	<u>Red Sand</u>	<u>20</u>	<u>65</u>
<b>WELL PURPOSE:</b> <u>Home</u> (home, irrigation, municipal, industrial)	<u>White sand + clay</u>	<u>65</u>	<u>125</u>
<b>WELL COMPLETION DATA:</b>	<u>White sand</u>	<u>125</u>	<u>165</u>
(1) diameter (inches) <u>4</u>			
(2) total depth (feet) <u>165</u>			
(3) static water level (feet) <u>120</u> below above top of ground.			
(4) casing <u>PVC</u> , <u>165</u> (material) (depth)			
<u>—</u> if telescope see back. (size)			
(5) screen <u>12</u> , <u>153</u> (length) (depth to top)			
<u>4"</u> , <u>gravel + PVC</u> (size) (material)			
(6) pump <u>1/2</u> , <u>10</u> (HP) (yield gpm)			
<u>220V</u> (type power)			
(7) electric log <u>No</u> (yes or no)			
<u>—</u> (organization running log)			
(8) how well bottom plugged <u>Cap</u>			

DEPT. OF NATURAL RESOURCES  
 BUREAU OF LAND & WATER RESOURCES


NOV 30 1981

RECEIVED

DRILLERS REMARKS:

If well telescopes please sketch and show depths.

GROUND LEVEL

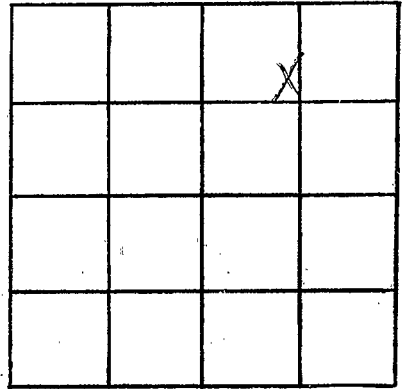

SECTION 18

Please indicate well location X.

ADDITIONAL INFORMATION

If more than one screen,  
show locations of each on sketch.