

MARSHALL

P 2057

12/1/1981

MISSISSIPPI
 BOARD OF WATER COMMISSIONERS
 416 North State Street
 Jackson, Mississippi 39201

WATER WELL DRILLERS LOG

Trustwell

Marshall

date well completed 19

firm name

county well located

LANDOWNER: *Benny Lopez*

description of formations encountered

from to

Helby Springs West
(mailing address)

<i>Clay</i>	0	30
<i>sand</i>	30	110
<i>Clay</i>	110	145
<i>sand</i>	145	180

WELL LOCATION:

sec. 2 T. 1 N. R. 3 E.
4 miles east of Helby Springs
 (distance) (direction) (nearest town)

WELL PURPOSE: *farm*
(home, irrigation, municipal, industrial)

WELL COMPLETION DATA:

- (1) diameter (inches) 4"
- (2) total depth (feet) 180
- (3) static water level (feet) 140 below top of ground.
- (4) casing PVC 170
(material) (depth)

if telescope see back.
(size)

- (5) screen 10' 170
(length) (depth to top)
4" PVC
(size) (material)

- (6) pump 3/4 12
(HP) (yield gpm)
elec
(type power)

- (7) electric log (yes or no)

(organization running log)

- (8) how well bottom plugged *Cop.*


DRILLERS REMARKS:

DEPT. OF NATURAL RESOURCES
 BUREAU OF LAND & WATER RESOURCES

DEC - 2 1981
 RECEIVED

If well telescopes please sketch and show depths.

GROUND LEVEL

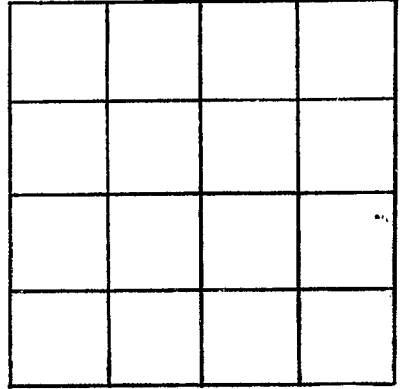

SECTION _____

Please indicate well location X.

ADDITIONAL INFORMATION

If more than one screen, show locations of each on sketch.