

MISSISSIPPI DEPARTMENT OF NATURAL RESOURCES

Bureau of Land and Water Resources

Southport Mall

P.O. Box 10631

Jackson, Mississippi 39209

WATER WELL DRILLERS LOG

P
2058

12-17-81 19
date well completed

Wilson Well Co Marshall
firm name county well located

LANDOWNER: Robert Jackson

PO Box 701
Holly Springs, Miss
(mailing address)

description of formations encountered	from	to
Red clay - Red sand	0	30
Red sand - white clay	30	60
White sand	60	105
White sand - Blue clay	105	120
White sand	120	135

WELL LOCATION:

sec. 8 T. 4 N R. 2 E
S W
1 miles S. Hwy 78 of Holly Springs
(distance) (direction) (nearest town)

WELL PURPOSE: Home
(home, irrigation, municipal, industrial)

WELL COMPLETION DATA:

- (1) diameter (inches) 4
- (2) total depth (feet) 128
- (3) static water level (feet) 50 below top of ground
- (4) casing Plastic (material) (depth)
4 (size) If telescope see back.
- (5) screen 10 (length) (depth to top)
4 Plastic (size) (material)
- (6) pump 3/4 8 (HP) (yield gpm)
electric (type power)
- (7) electric log NO (yes or no)

(organization running log)

(8) how well bottom plugged Plastic cap

DRILLERS REMARKS:


DEPT. OF NATURAL RESOURCES
BUREAU OF LAND & WATER RESOURCES

JAN 21 1982

RECEIVED

If well telescopes please
sketch and show depths.

GROUND LEVEL

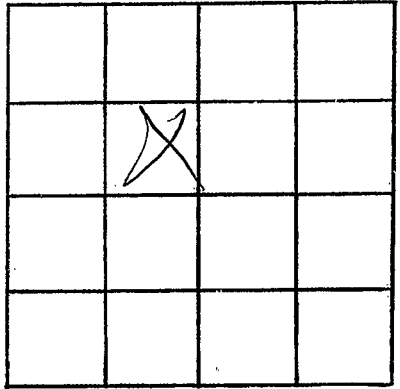

SECTION 8

Please indicate well location X.

ADDITIONAL INFORMATION

RECEIVED

82 JAN 21 A 8:42

If more than one screen,
show locations of each on sketch.