

MISSISSIPPI DEPARTMENT OF NATURAL RESOURCES

Bureau of Land and Water Resources

Southport Mall

P.O. Box 10631

Jackson, Mississippi 39209

WATER WELL DRILLERS LOG

Marshall  
P 2059  
12-14-81

12-14 1981 R.L. Carpenter Marshall  
 date well completed firm name county well located

LANDOWNER: <u>Dorothy Basler</u>	description of formations encountered	from	to
<u>Holly Springs, Miss</u> <u>RFD</u> (mailing address)			
WELL LOCATION: sec. <u>11</u> T- <u>4</u> N R- <u>2</u> E <u>3</u> miles <u>SE</u> of <u>H.S.</u> (distance) (direction) (nearest town)	<u>Surface Soil</u>	<u>0</u>	<u>30</u>
WELL PURPOSE: <u>Home</u> (home, irrigation, municipal, industrial)	<u>Med Red Sand</u>	<u>30</u>	<u>62</u>
WELL COMPLETION DATA: (1) diameter (inches) <u>4</u>	<u>Med &amp; Fine White Sand</u>	<u>62</u>	<u>110</u>
(2) total depth (feet) <u>275</u>	<u>White Clay</u>	<u>110</u>	<u>138</u>
(3) static water level (feet) <u>180</u> below above top of ground.	<u>White Coarse Sand</u>	<u>138</u>	<u>190</u>
(4) casing <u>PVC</u> <u>265'</u> (material) (depth)	<u>Med &amp; Fine White Sand</u>	<u>190</u>	<u>249</u>
(size) if telescope see back.	<u>White Coarse Sand</u>	<u>249</u>	<u>275</u>
(5) screen <u>10'</u> <u>265'</u> (length) (depth to top)			
<u>4"</u> <u>PVC</u> (size) (material)			
(6) pump <u>3/4</u> <u>10</u> (HP) (yield gpm)			
<u>Elec</u> (type power)			
(7) electric log <u>no</u> (yes or no)			
(organization running log)			
(8) how well bottom plugged <u>PVC Cap</u>			

DEPT. OF NATURAL RESOURCES  
 BUREAU OF LAND & WATER RESOURCES


SEP 7 1982

RECEIVED

DRILLERS REMARKS:

If well telescopes please sketch and show depths.

GROUND LEVEL

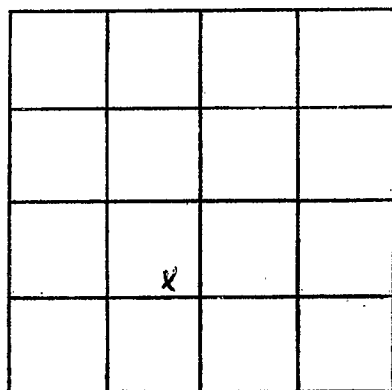

SECTION 11

Please indicate well location X.

ADDITIONAL INFORMATION

If more than one screen,  
show locations of each on sketch.