

**MISSISSIPPI DEPARTMENT OF NATURAL RESOURCES**  
**Bureau of Land and Water Resources**  
 Southport Mall  
 P.O. Box 10631  
 Jackson, Mississippi 39209  
**WATER WELL DRILLERS LOG**

**Marshall**  
**P 2060**  
**10-3-81**

Oct 3 1981 R. L. Carpenter Marshall  
 date well completed firm name county well located

LANDOWNER:	description of formations encountered	from	to
<u>Cecil Hunt</u> <u>Holly Springs, Min.</u> <u>RFD</u> (mailing address)			
<b>WELL LOCATION:</b> sec. <u>2</u> T. <u>4</u> N. R. <u>2</u> E. <u>2 1/2</u> miles <u>East</u> of <u>H.S.</u> (distance) (direction) (nearest town)	<u>Med White Sand</u>	<u>28</u>	<u>57</u>
<b>WELL PURPOSE:</b> (home, irrigation, municipal, industrial)	<u>Med of fine white sand</u>	<u>57</u>	<u>98</u>
<b>WELL COMPLETION DATA:</b>	<u>White Clay</u>	<u>98</u>	<u>130</u>
(1) diameter (inches) <u>4</u>	<u>White coarse sand</u>	<u>130</u>	<u>158</u>
(2) total depth (feet) <u>230</u>	<u>White Clay</u>	<u>158</u>	<u>190</u>
(3) static water level (feet) <u>172</u> below above top of ground.	<u>White coarse sand</u>	<u>190</u>	<u>230</u>
(4) casing <u>PVC</u> <u>220'</u> (material) (depth) (size) if telescope see back.			
(5) screen <u>10'</u> <u>220'</u> (length) (depth to top) <u>4"</u> <u>PVC</u> (size) (material)			
(6) pump <u>3/4</u> <u>10</u> (HP) (yield gpm) <u>Electric</u> (type power)			
(7) electric log <u>no</u> (yes or no) (organization running log)			
(8) how well bottom plugged <u>PVC Cap</u>			

DEPT. OF NATURAL RESOURCES  
 BUREAU OF LAND & WATER RESOURCES


SEP -7 1982

**RECEIVED**

DRILLERS REMARKS:

If well telescopes please sketch and show depths.

GROUND LEVEL

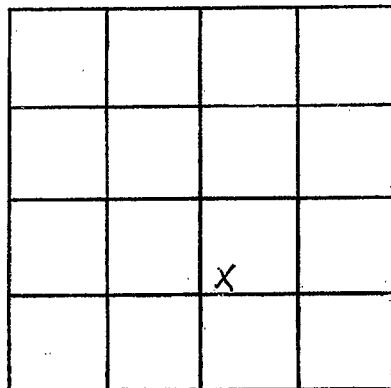

SECTION 2

Please indicate well location X.

ADDITIONAL INFORMATION

If more than one screen,  
show locations of each on sketch.