

MISSISSIPPI DEPARTMENT OF NATURAL RESOURCES

Bureau of Land and Water Resources

Southport Mall

P.O. Box 10631

Jackson, Mississippi 39209

WATER WELL DRILLERS LOG

Marshall  
P 2061

5-3

1982

R L Carpenter

Marshall

date well completed

firm name

county well located

LANDOWNER: Vester Mulls

Holly Springs

Ms. RFD

(mailing address)

description of formations encountered

from

to

Surface Soil

0

24

Med. Red Soil

24

40

Red Clay

40

65

White Clay

65

98

Fine White Sand

98

160

Med. White Sand

140

160

White coarse Sand

160

188

WELL LOCATION:

sec. 11 T. 4 N. R. 2 E.

S. W.

3

miles

SE of

His

(distance)

(direction)

(nearest town)

WELL PURPOSE:

7-toner

(home, irrigation, municipal, industrial)

WELL COMPLETION DATA:

(1) diameter (inches) 4

(2) total depth (feet) 188

(3) static water level (feet) 166 below top of ground.

(4) casing Plaster, 178,  
(material) (depth)

(size) if telescope see back.

(5) screen 10', 178'  
(length) (depth to top)

4", PVC  
(size) (material)

(6) pump 3/4, 10  
(HP) (yield gpm)

Elec.  
(type power)

(7) electric log no  
(yes or no)

(organization running log)

(8) how well bottom plugged PVC cap

DRILLERS REMARKS:


DEPT. OF NATURAL RESOURCES  
BUREAU OF LAND & WATER RESOURCES

OCT 29 1981

RECEIVED

If well telescopes please sketch and show depths.

GROUND LEVEL

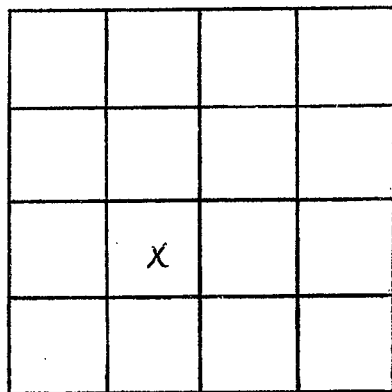

SECTION \_\_\_\_\_

Please indicate well location X.

ADDITIONAL INFORMATION

If more than one screen,  
show locations of each on sketch.