

MISSISSIPPI DEPARTMENT OF NATURAL RESOURCES

Bureau of Land and Water Resources

Southport Mall

P.O. Box 10631

Jackson, Mississippi 39209

WATER WELL DRILLERS LOG

Marshall  
P 2062

Nov. 10 19 82  
 date well completed

R. L. Carpenter  
 firm name

Marshall  
 county well located

LANDOWNER Edward J. Freeman

Holly Springs, Ms.

RFD  
 (mailing address)

description of formations encountered

from

to

Surface Soil 0 23

Med. Red Sand 23 41

Red clay 41 64

White clay 64 100

Fine White Sand 100 120

Med. & coarse white sand 120 189

WELL LOCATION:

sec. 11 T. 4 N R. 2 E  
 S W  
3 miles SE of H.S.  
 (distance) (direction) (nearest town)

WELL PURPOSE: None  
 (home, irrigation, municipal, industrial)

WELL COMPLETION DATA:

- (1) diameter (inches) 4
- (2) total depth (feet) 189
- (3) static water level (feet) 162 below above top of ground.

(4) casing Plastic, 179'  
 (material) (depth)

(size) If telescope see back.

(5) screen 10', 179'  
 (length) (depth to top)

4", PVC  
 (size) (material)

(6) pump 3/4, 12  
 (HP) (yield gpm)

Elec.  
 (type power)

(7) electric log no.  
 (yes or no)

(organization running log)

(8) how well bottom plugged PVC cap

DRILLERS REMARKS:


DEPT. OF NATURAL RESOURCES  
 BUREAU OF LAND & WATER RESOURCES

OCT 26 1984

RECEIVED

If well telescopes please  
sketch and show depths.

GROUND LEVEL

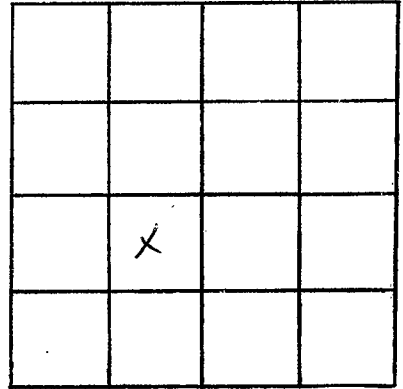

SECTION 11

Please indicate well location X.

ADDITIONAL INFORMATION

If more than one screen,  
show locations of each on sketch.