

MISSISSIPPI DEPARTMENT OF NATURAL RESOURCES
Bureau of Land and Water Resources
 Southport Mall
 P.O. Box 10631
 Jackson, Mississippi 39209
WATER WELL DRILLERS LOG

Marshall
P
2063

4-29 1982 HICKS WELL COMPANY Marshall
 date well completed DT 1 - BOX 182 name county well located

LANDOWNER: <u>Floyd Murdock</u>	description of formations encountered	from	to
<u>Box 182</u>			
<u>Holly Springs, Miss. 38635</u> (mailing address)	<u>Red Clay</u>	<u>0</u>	<u>10</u>
	<u>Red sand</u>	<u>10</u>	<u>50</u>
WELL LOCATION: sec. <u>24</u> T. <u>4</u> N. R. <u>2</u> E. <u>5</u> miles <u>SE</u> of <u>Holly Springs</u> (distance) (direction) (nearest town)	<u>White Sand + Clay</u>	<u>50</u>	<u>180</u>
	<u>White Sand</u>	<u>180</u>	<u>245</u>
WELL PURPOSE: <u>Home</u> (home, irrigation, municipal, industrial)			
WELL COMPLETION DATA:			
(1) diameter (inches) <u>4</u>			
(2) total depth (feet) <u>245</u>			
(3) static water level (feet) <u>210</u> below above top of ground.			
(4) casing <u>PVC</u> , <u>245</u> (material) (depth)			
<u> </u> if telescope see back. (size)			
(5) screen <u>10</u> , <u>235</u> (length) (depth to top)			
<u>08</u> , <u>PVC</u> (size) (material)			
(6) pump <u>3/4</u> , <u>10</u> (HP) (yield gpm)			
<u>220V</u> (type power)			
(7) electric log <u>no</u> (yes or no)			
<u> </u> (organization running log)			
(8) how well bottom plugged <u>Cap</u>			

DEPT. OF NATURAL RESOURCES
 BUREAU OF LAND & WATER RESOURCES


MAY 10 1982

RECEIVED

DRILLERS REMARKS:

If well telescopes please sketch and show depths.

GROUND LEVEL

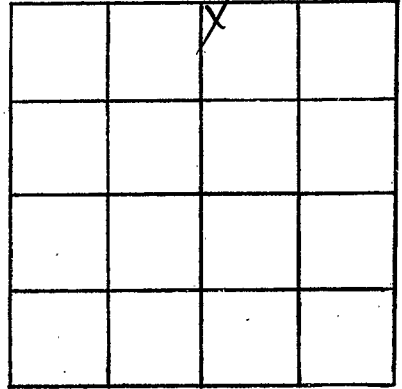

SECTION 24

Please indicate well location X.

ADDITIONAL INFORMATION

Lined area for additional information.

If more than one screen, show locations of each on sketch.