

MISSISSIPPI DEPARTMENT OF NATURAL RESOURCES

Bureau of Land and Water Resources

Southport Mall

P.O. Box 10631

Jackson, Mississippi 39209

WATER WELL DRILLERS LOG

HICKS WELL CO.

Rt. 1 Box 157

Marshall
P
2064

Marshall
county well located

328 19 83 date well completed

firm name

LANDOWNER: Bonny Collins
Rt. 1 Chewalla Rd.
Holly Springs, Mo. 38635
(mailing address)

description of formations encountered

from

to

clay

0 10

Red sand

10 50

white sand

50 260

WELL LOCATION:

sec. 11 T 4 N R 2 E
3 miles E of Holly Springs
(distance) (direction) (nearest town)

WELL PURPOSE: None
(home, irrigation, municipal, industrial)

WELL COMPLETION DATA:

- (1) diameter (inches) 4
- (2) total depth (feet) 260
- (3) static water level (feet) 190 ^{below} _{above} top of ground.
- (4) casing PVC 260, 4"
(material) (depth) (size) If telescope see back.
- (5) screen 15', 245'
(length) (depth to top)
813, PVC
(size) (material)
- (6) pump 3/4, 10
(HP) (yield gpm)
220V
(type power)
- (7) electric log No
(yes or no)

(organization running log)

(8) how well bottom plugged Cap

DRILLERS REMARKS:


DEPT. OF NATURAL RESOURCES
BUREAU OF LAND & WATER RESOURCES

APR - 4 1983

RECEIVED

If well telescopes please sketch and show depths.

GROUND LEVEL

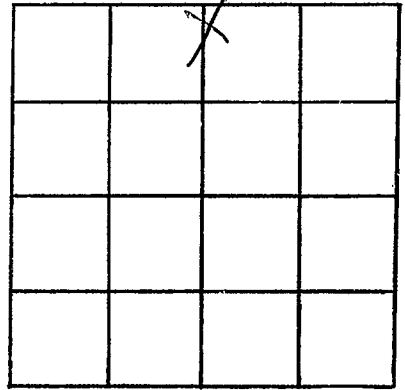

SECTION 11

Please indicate well location X.

ADDITIONAL INFORMATION

If more than one screen,
show locations of each on sketch.