

Marshall
P 2065

MISSISSIPPI DEPARTMENT OF NATURAL RESOURCES
Bureau of Land and Water Resources
Southport Mall
P.O. Box 10631
Jackson, Mississippi 39209
WATER WELL DRILLERS LOG

4-20 1983
date well completed

HICKS WELL #2

Marshall
county well located

LANDOWNER: Clton Collins
Rt. 1
Holly Springs, Miss.
(mailing address) 38635

description of formations encountered	from	to
<u>Red clay</u>	<u>0</u>	<u>10</u>
<u>Red sand</u>	<u>10</u>	<u>55</u>
<u>White sand</u>	<u>55</u>	<u>95</u>
<u>Black clay</u>	<u>95</u>	<u>135</u>

WELL LOCATION:
sec. 35 T 4 N R 2 E
1/2 miles S of Lake Center
(distance) (direction) (nearest town)

WELL PURPOSE: Home
(home, irrigation, municipal, industrial)

- WELL COMPLETION DATA:
- (1) diameter (inches) 4
 - (2) total depth (feet) 135
 - (3) static water level (feet) 607 below top of ground.
 - (4) casing PVC (material), 135 (depth),
4 (size) if telescope see back.
 - (5) screen 15' (length), 175' (depth to top),
013 (size), PVC (material)
 - (6) pump 3/4 (HP), 5 (yield gpm),
220V (type power)
 - (7) electric log No (yes or no)
- (organization running log)
- (8) how well bottom plugged Cap

DRILLERS REMARKS:


DEPT. OF NATURAL RESOURCES
BUREAU OF LAND & WATER RESOURCES

MAY 25 1983

RECEIVED

If well telescopes please sketch and show depths.

GROUND LEVEL

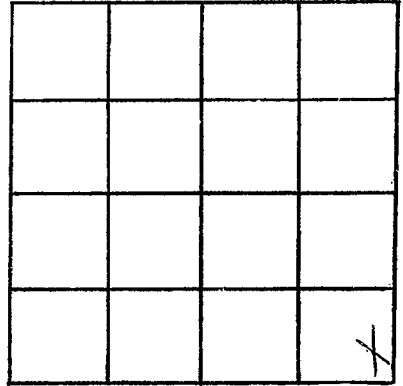

SECTION 35

Please indicate well location X.

ADDITIONAL INFORMATION

If more than one screen,
show locations of each on sketch.