

MISSISSIPPI DEPARTMENT OF NATURAL RESOURCES

Bureau of Land and Water Resources

Southport Mall

P.O. Box 10631

Jackson, Mississippi 39209

WATER WELL DRILLERS LOG

HICKS WELL CO.

Rt. 1, Box 157

Senatobia, MS 38688

Marshall
P 2066

Marshall

4-21 19 83
date well completed

county well located

LANDOWNER:	description of formations encountered	from	to
<u>Colonial Asphalt Co.</u>			
<u>P.O. Box</u>	<u>Red Sand</u>	<u>0</u>	<u>80</u>
<u>Holly Springs, Miss.</u> (mailing address) <u>38635</u>	<u>White Sand</u>	<u>80</u>	<u>95</u>
WELL LOCATION:	<u>White Clay</u>	<u>95</u>	<u>100</u>
sec. <u>7</u> T. <u>4</u> N. R. <u>2</u> E	<u>White Sand</u>	<u>100</u>	<u>230</u>
— miles — of <u>Holly Springs</u>			
(distance) (direction) (nearest town)			
WELL PURPOSE: <u>Industrial</u> (home, irrigation, municipal, industrial)			
WELL COMPLETION DATA:			
(1) diameter (inches) <u>4</u>			
(2) total depth (feet) <u>230</u>			
(3) static water level (feet) <u>170</u> <u>below</u> top of ground. <u>above</u>			
(4) casing <u>PVC</u> , <u>230</u> , (material) (depth)			
<u>4"</u> (size) if telescope see back.			
(5) screen <u>20'</u> , <u>210'</u> (length) (depth to top)			
<u>013</u> , <u>PVC</u> (size) (material)			
(6) pump <u>3</u> , <u>45</u> (HP) (yield gpm)			
<u>220V</u> (type power)			
(7) electric log <u>No</u> (yes or no)			
(organization running log)			
(8) how well bottom plugged <u>Cap</u>			
DRILLERS REMARKS:			


DEPT. OF NATURAL RESOURCES
BUREAU OF LAND & WATER RESOURCES

MAY 25 1983

RECEIVED

If well telescopes please sketch and show depths.

GROUND LEVEL

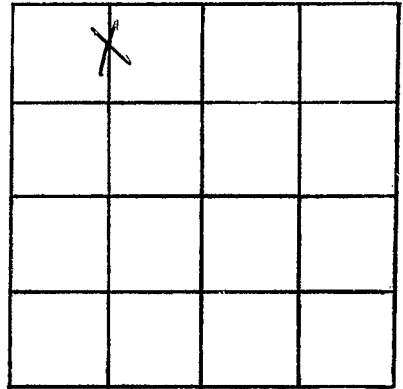

SECTION 7

Please indicate well location X.

ADDITIONAL INFORMATION

If more than one screen, show locations of each on sketch.