

MISSISSIPPI DEPARTMENT OF NATURAL RESOURCES
Bureau of Land and Water Resources
 Southport Mall
 P.O. Box 10631
 Jackson, Mississippi 39209
WATER WELL DRILLERS LOG

Marshall
 P 2067

Marshall

6-13 1983
 date well completed

HICKS WELL CO
 firm name

county well located

LANDOWNER: *James Smith*
Rt. 1 Box 333
Potts Camp, Miss.
 (mailing address)

description of formations encountered	from	to
<i>Red clay</i>	<i>0</i>	<i>20</i>
<i>Red sand</i>	<i>20</i>	<i>60</i>
<i>White sand</i>	<i>60</i>	<i>125</i>
<i>Black clay</i>	<i>125</i>	<i>146</i>

WELL LOCATION:
 sec *26* T *4* N R *2* E
 (distance) *1* miles (direction) *NW* (nearest town) *Lake Center*

WELL PURPOSE: *Home*
 (home, irrigation, municipal, industrial)

- WELL COMPLETION DATA:
- (1) diameter (inches) *4*
 - (2) total depth (feet) *140*
 - (3) static water level (feet) *100* ^{below}/_{above} top of ground.
 - (4) casing *PVC*, *140*,
 (material) (depth)
4 (size) If telescope see back.
 - (5) screen *10' ~~10~~*, *100*
 (length) (depth to top)
.013, *PVC*
 (size) (material)
 - (6) pump *1/2*, *10*
 (HP) (yield gpm)
220V
 (type power)
 - (7) electric log *No*
 (yes or no)

(organization running log)

(8) how well bottom plugged *Caps*

DRILLERS REMARKS:


DEPT. OF NATURAL RESOURCES
 BUREAU OF LAND & WATER RESOURCES

JUN 27 1983

RECEIVED

If well telescopes please sketch and show depths.

GROUND LEVEL

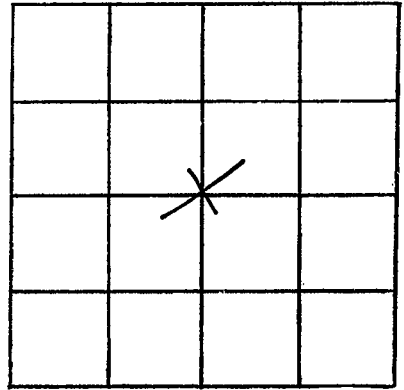

SECTION 26

Please indicate well location X.

ADDITIONAL INFORMATION

If more than one screen, show locations of each on sketch.