

MISSISSIPPI DEPARTMENT OF NATURAL RESOURCES

Bureau of Land and Water Resources

Southport Mall

P.O. Box 10631

Jackson, Mississippi 39209

WATER WELL DRILLERS LOG

Marshall
P 2068

Marshall

9-15 1983
date well completed

HICKS WELL CO.

Rt. 1, Box 257

county well located

LANDOWNER: Joe Dunlap
Rt. 1

description of formations encountered	depth	
	from	to

Holly Springs, Mo. 38635
(mailing address)

<u>Red Sand</u>	<u>0</u>	<u>30</u>
<u>Red sand + Clay</u>	<u>30</u>	<u>70</u>

WELL LOCATION:
sec. 16 T 4 N R. 2 E
1 1/2 miles SE of Holly Springs
(distance) (direction) (nearest town)

<u>White Sand</u>	<u>70</u>	<u>240</u>
-------------------	-----------	------------

WELL PURPOSE: Home
(home, irrigation, municipal, industrial)

WELL COMPLETION DATA:

- (1) diameter (inches) 4
- (2) total depth (feet) 240
- (3) static water level (feet) 160 ^{below} above top of ground.
- (4) casing PVC 240
(material) (depth)
4" if telescope see back.
(size)
- (5) screen 10' 230'
(length) (depth to top)
.013 PVC
(size) (material)
- (6) pump 3/4 10
(HP) (yield gpm)
220V
(type power)
- (7) electric log no
(yes or no)

(organization running log)

(8) how well bottom plugged Cap

DRILLERS REMARKS:


DEPT. OF NATURAL RESOURCES
BUREAU OF LAND & WATER RESOURCES

SEP 22 1983

RECEIVED

If well telescopes please sketch and show depths.

GROUND LEVEL

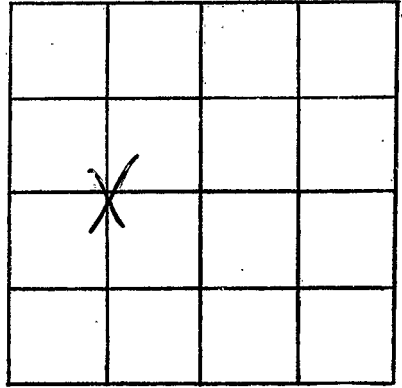

SECTION 16

Please indicate well location X.

ADDITIONAL INFORMATION

If more than one screen, show locations of each on sketch.