

MISSISSIPPI DEPARTMENT OF NATURAL RESOURCES

Bureau of Land and Water Resources

Southport Mall

P.O. Box 10631

Jackson, Mississippi 39209

WATER WELL DRILLERS LOG

Marshall  
P 2071

HICKS WELL CO.

157  
Senatobia MS 38662

Marshall  
county well located

P-14 19 84  
date well completed

LANDOWNER: Sammy E. Brey

description of formations encountered

from to

Pt. 1

Red Clay

0 10

Holly Springs, Ms 38635  
(mailing address)

White Sand & Clay

10 250

WELL LOCATION:

sec. 13 T 4 N R. 2 E  
3 miles N of Lake Center  
(distance) (direction) (nearest town)

White Sand

250 245

WELL PURPOSE: Home  
(home, irrigation, municipal, industrial)

WELL COMPLETION DATA:

- (1) diameter (inches) 4
- (2) total depth (feet) 245
- (3) static water level (feet) 160 <sup>below</sup> above top of ground.
- (4) casing PVC, 245,  
(material) (depth)  
4"  
(size) if telescope see back.
- (5) screen 10', 235'  
(length) (depth to top)  
.010, PVC  
(size) (material)
- (6) pump #3 1/2, 10  
(HP) (yield gpm)  
220V  
(type power)
- (7) electric log No  
(yes or no)

(organization running log)

(8) how well bottom plugged Cap

DRILLERS REMARKS:


DEPT. OF NATURAL RESOURCES  
BUREAU OF LAND & WATER RESOURCES

SEP 24 1984

RECEIVED

If well telescopes please sketch and show depths.

GROUND LEVEL

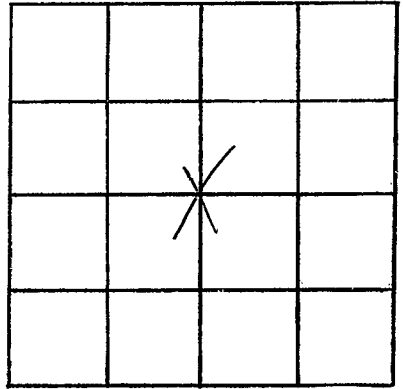

SECTION 13

Please indicate well location X.

ADDITIONAL INFORMATION

If more than one screen,  
show locations of each on sketch.