

MISSISSIPPI DEPARTMENT OF NATURAL RESOURCES

Bureau of Land and Water Resources

Southport Mall

P.O. Box 10631

Jackson, Mississippi 39209

WATER WELL DRILLERS LOG

~~Marshall~~ *Marshall*
P 2072

Marshall
Foto

8-~~30~~30 19 84
date well completed

HICKS WELL CO.
firm name
Saratoga MS 39068

county well located

LANDOWNER: *Willie Robertson*
Rt 5
Holly Springs, Ms. 38635
(mailing address)

| description of formations encountered | from | to |
|---------------------------------------|-----------|------------|
| <i>Red Sand</i> | <i>0</i> | <i>20</i> |
| <i>white sand</i> | <i>80</i> | <i>205</i> |

WELL LOCATION:
sec. *18* T *4* N R *2* E
1 miles *S* of *Holly Springs*
(distance) (direction) (nearest town)

WELL PURPOSE: *Home*
(home, irrigation, municipal, industrial)

WELL COMPLETION DATA:

(1) diameter (inches) *4*

(2) total depth (feet) *205*

(3) static water level (feet) *170* ^{below}/_{above} top of ground.

(4) casing *PVC*, *205*,
(material), (depth)
4"
(size) if telescope see back.

(5) screen *10'*, *195'*
(length), (depth to top)
1010, *PVC*
(size), (material)

(6) pump *3/4*, *10*
(HP), (yield gpm)
220V
(type power)

(7) electric log *No*
(yes or no)

(organization running log)

(8) how well bottom plugged *Cap*

DRILLERS REMARKS:


DEPT. OF NATURAL RESOURCES
BUREAU OF LAND & WATER RESOURCES

SEP 24 1984

RECEIVED

If well telescopes please sketch and show depths.

GROUND LEVEL

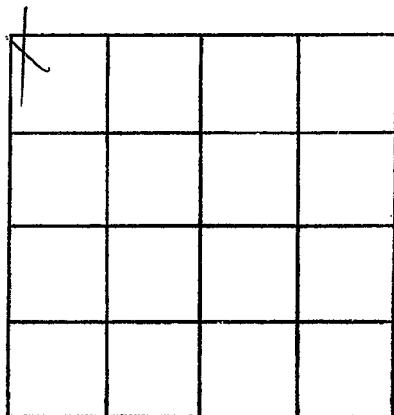

SECTION 18

Please indicate well location X.

ADDITIONAL INFORMATION

If more than one screen,
show locations of each on sketch.