

MISSISSIPPI DEPARTMENT OF NATURAL RESOURCES

Bureau of Land and Water Resources

Southport Mall

P.O. Box 10631

Jackson, Mississippi 39209

WATER WELL DRILLERS LOG

Marshall
P 2073
Nov 29 - 84
~~11/28~~ 19 84
date well completed

R. L. Carpenter firm name
Marshall county well located

LANDOWNER: Oliver Burks
Holy Springs,
Tn.
(mailing address)

WELL LOCATION:
sec. 2 T 4 N R 2 E
S W
2 1/2 miles SE of H.S.
(distance) (direction) (nearest town)

WELL PURPOSE: Home
(home, irrigation, municipal, industrial)

WELL COMPLETION DATA:

- (1) diameter (inches) 4
- (2) total depth (feet) 210
- (3) static water level (feet) 176 below above top of ground.
- (4) casing Plastic, 200' (material) (depth)
____ if telescope see back.
(size)
- (5) screen 10', 300' (length) (depth to top)
4", PVC (size) (material)
- (6) pump 3/4, 10 (HP) (yield gpm)
3 sec. (type power)
- (7) electric log no (yes or no)
____ (organization running log)
- (8) how well bottom plugged PVC Cops

description of formations encountered	from	to
<u>Surface Soil</u>	<u>0</u>	<u>18</u>
<u>Med. Red Sand</u>	<u>18</u>	<u>28</u>
<u>Red Clay</u>	<u>28</u>	<u>60</u>
<u>White Clay</u>	<u>60</u>	<u>98</u>
<u>Med. White Sand</u>	<u>90</u>	<u>130</u>
<u>White coarse sand</u>	<u>130</u>	<u>210</u>

DEPT. OF NATURAL RESOURCES
BUREAU OF LAND & WATER RESOURCES


OCT 29 1984

RECEIVED

DRILLERS REMARKS:

If well telescopes please sketch and show depths.

GROUND LEVEL

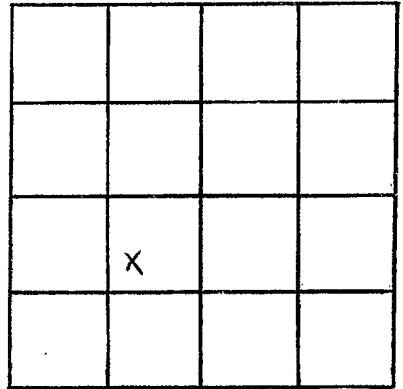

SECTION 2

Please indicate well location X.

ADDITIONAL INFORMATION

If more than one screen,
show locations of each on sketch.