

MISSISSIPPI DEPARTMENT OF NATURAL RESOURCES

Bureau of Land and Water Resources

Southport Mall

P.O. Box 10631

Jackson, Mississippi 39209

WATER WELL DRILLERS LOG

Marshall
P 2074

HICKS WELL CO.
firm Marshall
Box 157
Senatobia, MS 38668

Marshall
county well located

10-19 19 84
date well completed

LANDOWNER: Annie Campbell
Rt 1 Chewalla Rd.
Holly Springs, Ms.
(mailing address)

description of formations encountered	from	to
<u>Red Clay</u>	<u>0</u>	<u>10</u>
<u>Red Sand</u>	<u>10</u>	<u>30</u>
<u>white sand + clay</u>	<u>30</u>	<u>80</u>
<u>white sand</u>	<u>80</u>	<u>245</u>

WELL LOCATION:
sec. 26 4 N 2 E
(S) (W)
2 miles NW of Lake Center
(distance) (direction) (nearest town)

WELL PURPOSE: Home
(home, irrigation, municipal, industrial)

- WELL COMPLETION DATA:
- (1) diameter (inches) 4
 - (2) total depth (feet) 245
 - (3) static water level (feet) 1 PS below above top of ground.
 - (4) casing PVC, 245
(material) (depth)
OVER if telescope see back.
(size)
 - (5) screen 30', 185'
(length) (depth to top)
0.10, PVC
(size) (material)
 - (6) pump 3/4, 10
(HP) (yield gpm)
220V
(type power)
 - (7) electric log No
(yes or no)
 - (organization running log)
 - (8) how well bottom plugged Cap

DRILLERS REMARKS:



DEPT. OF NATURAL RESOURCES
BUREAU OF LAND & WATER RESOURCES

NOV 28 1984

RECEIVED

If well telescopes please sketch and show depths.

GROUND LEVEL

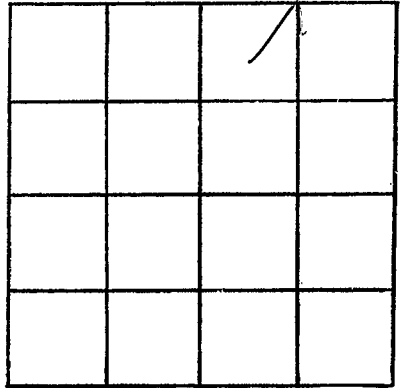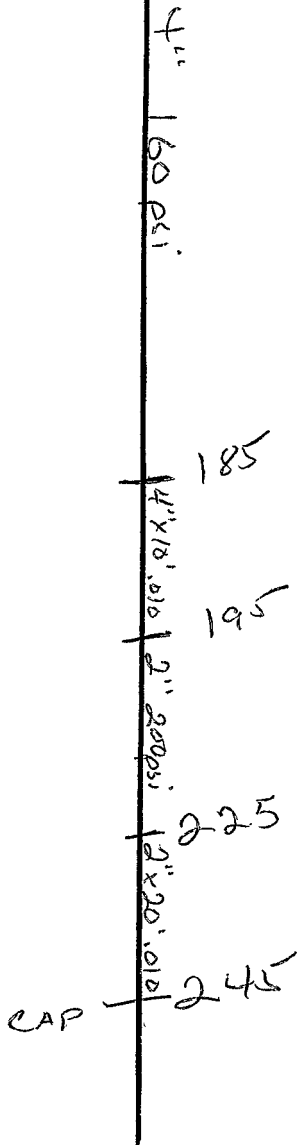

SECTION 26

Please indicate well location X.

ADDITIONAL INFORMATION

A series of horizontal lines for writing additional information.

If more than one screen, show locations of each on sketch.