

MISSISSIPPI DEPARTMENT OF NATURAL RESOURCES

Bureau of Land and Water Resources

Southport Mall

P.O. Box 10631

Jackson, Mississippi 39209

WATER WELL DRILLERS LOG

HICKS WELL COMPANY

Marshall

P 2076
Marshall
6-26-85

6-26-1985
date well completed

Rt. 1, Box 157

county well located

SENATOBIA, MISS.

LANDOWNER: Willie Perkins

description of formations encountered

from to

C. Hewall Rd

Red clay

0 20

Holly Springs 38835
(mailing address)

Red Sand

20 60

WELL LOCATION:

sec. 11 T 4 N R 2 E
4 miles SE of Holly Springs
(distance) (direction) (nearest town)

Black clay

60 90

White Sand

90 260

WELL PURPOSE: Home
(home, irrigation, municipal, industrial)

WELL COMPLETION DATA:

- (1) diameter (inches) 4"
- (2) total depth (feet) 260'
- (3) static water level (feet) 200' below top of ground.
- (4) casing PVC, 250' (depth), 4" (size) if telescope see back.
- (5) screen 10' (length), 250' (depth to top), .03 (size), PVC (material)
- (6) pump 3/4 (HP), 10 (yield gpm), 220 V (type power)
- (7) electric log NO (yes or no)

(organization running log)

(8) how well bottom plugged Cap

DRILLERS REMARKS:


RECEIVED

SEP 20 1985

Department of Natural Resources
Bureau of Land & Water Resources

If well telescopes please sketch and show depths.

GROUND LEVEL

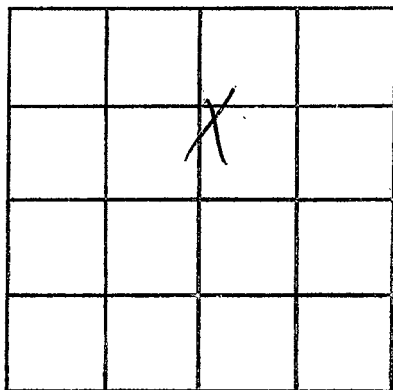

SECTION 11

Please indicate well location X.

ADDITIONAL INFORMATION

If more than one screen,
show locations of each on sketch.