

MISSISSIPPI DEPARTMENT OF NATURAL RESOURCES

Bureau of Land and Water Resources

Southport Mall

P.O. Box 10631

Jackson, Mississippi 39209

WATER WELL DRILLERS LOG

MARSHALL
P 2077

10-23 1985
date well completed

HICKS WELL COMPANY
RT. 1 Box 457

Marshall
county well located

LANDOWNER: Orin Spright

SENATUBIA, MISS.
description of formations encountered

Holly Springs, MS 39035
(mailing address)

description of formations encountered	from	to
Red clay	0	10
Red sand	10	30
9 1/2 to sand & white clay	30	125
9 1/2 to sand	125	250

WELL LOCATION:

sec. 11 T 4 N R 2 E
S W
4 miles E of Holly Springs
(distance) (direction) (nearest town)

WELL PURPOSE: Home
(home, irrigation, municipal, industrial)


WELL COMPLETION DATA:

- (1) diameter (inches) 4"
- (2) total depth (feet) 250'
- (3) static water level (feet) 20' below above top of ground.
- (4) casing PVC, 240'
(material) (depth)
4" If telescope see back.
(size)
- (5) screen 10', 240'
(length) (depth to top)
.013, PVC
(size) (material)
- (6) pump 3/4, 10
(HP) (yield gpm)
220V
(type power)
- (7) electric log NO
(yes or no)

(organization running log)

(8) how well bottom plugged Cap


DRILLERS REMARKS: 250'-265'
has 2" screen

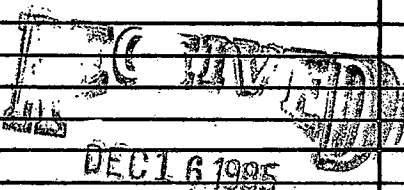

Department of Natural Resources
Bureau of Land and Water Resources

If well telescopes please sketch and show depths.

GROUND LEVEL

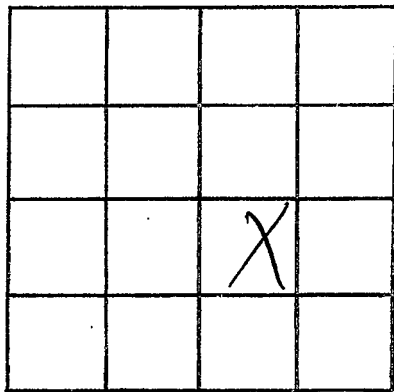

SECTION 11

Please indicate well location X.

ADDITIONAL INFORMATION

If more than one screen,
show locations of each on sketch.