

Marshall
P 2079

MISSISSIPPI DEPARTMENT OF NATURAL RESOURCES
Bureau of Land and Water Resources
Southport Mall
P.O. Box 10631
Jackson, Mississippi 39209
WATER WELL DRILLERS LOG

1-6 1986 HICKS WELL COMPANY Marshall
date well completed Rt. 1 - Hwy 157 county well located

LANDOWNER: Jannie Lee Crane
Rt # 1
Holly Springs MS 37635
(mailing address)

WELL LOCATION:
sec. 11 T 4 N R 2 E
S W
3 miles E of Holly Springs
(distance) (direction) (nearest town)


WELL PURPOSE: None
(home, irrigation, municipal, industrial)

WELL COMPLETION DATA:

- (1) diameter (inches) 4"
- (2) total depth (feet) 260'
- (3) static water level (feet) 180' below above top of ground.
- (4) casing PVC, 250' (material) (depth)
4" (size) if telescope see back.
- (5) screen 10' (length), 250' (depth to top)
0.13 (size), PVC (material)
- (6) pump 3/4 (HP), 10 (yield gpm)
220 ✓ (type power)
- (7) electric log NO (yes or no)
(organization running log)
- (8) how well bottom plugged Cap

DRILLERS REMARKS:

description of formations encountered	from	to
red clay	0	10
red sand	10	30
white sand	30	60
white sand & clay	60	80
White sand	80	260

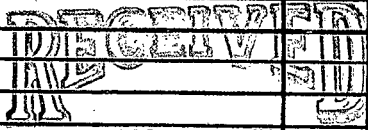


MAY 19 1986

Department of Natural Resources
Bureau of Land & Water Resources

If well telescopes please sketch and show depths.

GROUND LEVEL

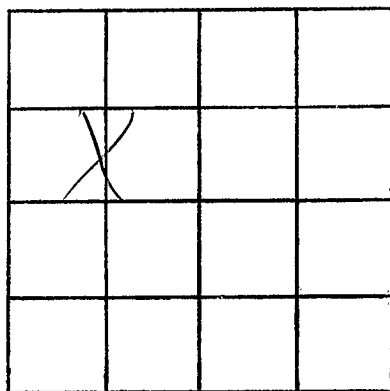

SECTION 10

Please indicate well location X.

ADDITIONAL INFORMATION

If more than one screen,
show locations of each on sketch.