

MISSISSIPPI DEPARTMENT OF NATURAL RESOURCES
 Bureau of Land and Water Resources
 Southport Mall
 P.O. Box 10631
 Jackson, Mississippi 39209
WATER WELL DRILLERS LOG

Marshall
D 2080

4-9 1986 St. Larry Carpenter Wells Marshall
 date well completed firm name county well located

LANDOWNER: Jerome Lesure
Holly Springs,
Ms. RFD
 (mailing address)

description of formations encountered	from	to
<u>Med. Brown sand</u>	<u>0</u>	<u>25</u>
<u>Med white sand</u>	<u>25</u>	<u>60</u>
<u>White Clay</u>	<u>60</u>	<u>75</u>
<u>White coarse sand</u>	<u>75</u>	<u>110</u>


WELL LOCATION:
 sec. 4 T. 4 N R. 2 E
 S W
1/2 miles East of H.S.
 (distance) (direction) (nearest town)

WELL PURPOSE: Home
 (home, irrigation, municipal, industrial)

WELL COMPLETION DATA:

- (1) diameter (inches) 4
- (2) total depth (feet) 110
- (3) static water level (feet) _____ below above top of ground.
- (4) casing PVC, 100'
 (material) (depth)
 _____ If telescope see back.
 (size)
- (5) screen 10', 100'
 (length) (depth to top)
4", PVC
 (size) (material)
- (6) pump 1/2, 10
 (HP) (yield gpm)
Elec
 (type power)
- (7) electric log no
 (yes or no)

 (organization running log)
- (8) how well bottom plugged Pvc cap

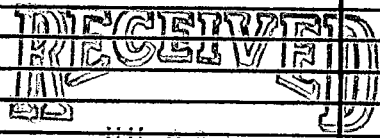

Department of Natural Resources
 Bureau of Land & Water Resources

DRILLERS REMARKS:

If well telescopes please
sketch and show depths.

GROUND LEVEL

X			

SECTION 4

Please indicate well location X.

ADDITIONAL INFORMATION

If more than one screen,
show locations of each on sketch.