

**MISSISSIPPI DEPARTMENT OF ENVIRONMENTAL QUALITY**  
Bureau of Land and Water Resources

P. O. Box 10631  
Jackson, MS 39289-0631  
**WATER WELL DRILLERS LOG**

COUNTY WELL LOCATED <i>Marshall</i>	
WELL NUMBER <i>P 2100</i>	CODED
DATE WELL COMPLETED <i>8-26-92</i>	

PERMIT NUMBER
NAME OF DRILLER <b>HICKS WELL CO.</b>
RT. 1 BOX 157 <b>SENATOBIA, MS 38668</b>

NAME & MAILING ADDRESS OF LANDOWNER <i>Bobby Mc Gregory</i>			
<i>RT-1 BOX 111E</i>			
<i>Holly Springs, MS.</i>			
WELL LOCATION:	SEC	TOWNSHIP	RANGE
	<i>4</i>	<i>4</i>	<i>2</i>
DISTANCE	DIRECTION	NEAREST TOWN	
<i>2</i> Miles	<i>N/E</i>	of <i>Holly Springs</i>	
OTHER LANDMARK			
WELL PURPOSE: <input checked="" type="checkbox"/> Home Irrigation, <input type="checkbox"/> Municipal, <input type="checkbox"/> Industrial, <input type="checkbox"/> Fish Pond, etc.			

<b>PUMP DATA</b>		
PUMP TYPE (Circle One): <input checked="" type="checkbox"/> Submersible, <input type="checkbox"/> Turbine, <input type="checkbox"/> Jet, <input type="checkbox"/> Flowing Well, Other (Describe) _____		
POWER TYPE (Circle One): <input checked="" type="checkbox"/> Electric, <input type="checkbox"/> Tractor, <input type="checkbox"/> Diesel, <input type="checkbox"/> Gasoline, <input type="checkbox"/> Butane, Other (Describe) _____ H/P <i>3/4</i>		
Pump Capacity (GPM) <i>10</i>	No. of Stages <i>12</i>	Setting Depth <i>200</i> FT.
PUMP TEST		
Well yielded _____ GPM with a drawdown of _____ ft. after _____ hours of pumping		

<b>WELL DATA</b>		
Well Depth <i>240</i>	Casing Diameter (In.) <i>4"</i>	Casing Length (Ft.) <i>230</i>
Type of Casing <i>PVC</i>	Hole Depth <i>240</i>	Depth to Static Water Level <i>160</i>
TYPE OF COMPLETION: (Circle One or More): <input checked="" type="checkbox"/> Gravel Packed, <input type="checkbox"/> Underreamed, <input type="checkbox"/> Telescoped, <input type="checkbox"/> Natural Development, <input type="checkbox"/> Open Hole, <input type="checkbox"/> Other (Describe) _____		
Top of Lap Pipe or Reduction in Casing		
FEET	IF TELESCOPED OR MORE THAN ONE SCREEN: USE BACK PAGE	

<b>LOG DATA</b>	
TYPE OF LOG RUN (Circle One): <input type="checkbox"/> No Log Run, <input type="checkbox"/> Electric, <input type="checkbox"/> Gamma Ray, <input type="checkbox"/> Density, <input type="checkbox"/> Sonic, <input type="checkbox"/> Neutron, Other (Describe) _____	
Name of Organization Running Log	

<b>SCREEN DATA</b>		
Diameter - Inches <i>4"</i>	Length - Feet <i>10'</i>	Slot Size - Inches <i>013</i>
Screen Type <i>PVC</i>	Depth to Bottom - Feet <i>10'</i>	

<b>GEOLOGIC DATA (Office Use Only)</b>			
Surface Elev.	Geologic Unit	Unit Thickness	Depth to Top
Subs. SWL	Date	Analysis	Aquifer Test
Driller's Remarks			

DESCRIPTION OF FORMATIONS ENCOUNTERED	FROM	TO	FORMATIONS (Continued)	FROM	TO
<i>clay &amp; sand</i>	<i>0</i>	<i>40</i>			
<i>r/s</i>	<i>40</i>	<i>160</i>			
<i>w/s</i>	<i>160</i>	<i>240</i>			

**RECEIVED**


OCT 23 1992

Dept. of Environmental Quality  
Bureau of Land & Water Resources

IF MORE SPACE IS NEEDED, USE BACK

If well telescopes please sketch and show depths.

GROUND LEVEL

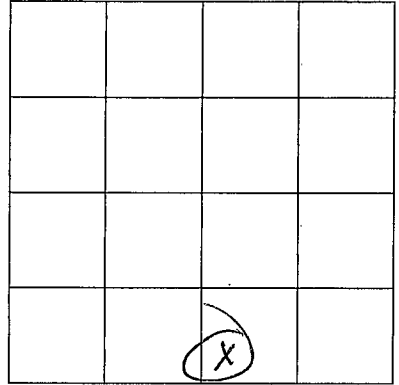

SECTION \_\_\_\_\_

Please indicate well location X.

ADDITIONAL INFORMATION

If more than one screen,  
show location of each on sketch.