

Marshall  
Q1  
7-3-70

MISSISSIPPI  
 BOARD OF WATER COMMISSIONERS  
 416 North State Street  
 Jackson, Mississippi 39201

**CODED**

WATER WELL DRILLERS LOG

7-3 19 70 Robert W. Wilson Marshall  
 date well completed firm name county well located

LANDOWNER: Wesley Rayston  
Potts Camp  
MISS.  
 (mailing address)

description of formations encountered	from	to
<u>Red Clay - Red Sand</u>	<u>0</u>	<u>20</u>
<u>Red Sand white Clay</u>	<u>20</u>	<u>40</u>
<u>white Clay white Sand</u>	<u>40</u>	<u>60</u>
<u>white sand</u>	<u>60</u>	<u>86</u>

WELL LOCATION:  
 sec. 11 T 4 N R 7 E  
 (distance) miles of (direction) (nearest town)

WELL PURPOSE:  
 (home, irrigation, municipal, industrial)

- WELL COMPLETION DATA:
- (1) diameter (inches) 4
  - (2) total depth (feet) 86
  - (3) static water level (feet) 60 below above top of ground.
  - (4) casing plastic 82  
 (material) (depth)  
4 If telescope see back.  
 (size)
  - (5) screen 4 82  
 (length) (depth to top)  
4 Gravel Pack  
 (size) (material)
  - (6) pump 1/2 10  
 (HP) (yield gpm)  
Electric  
 (type power)
  - (7) electric log yes (yes or no)
  - (organization running log) yes
  - (8) how well bottom plugged plastic cap

**CODED**


JUL 21 1970

MISS. DE. OF  
 WATER COMM.

DRILLERS REMARKS:

If well telescopes please sketch and show depths.

GROUND LEVEL

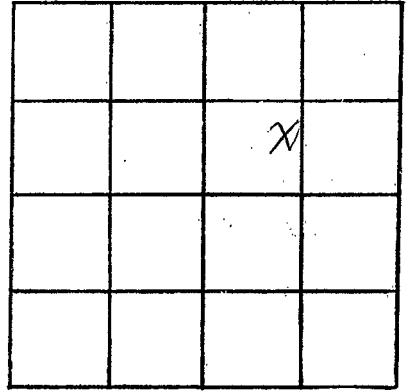

SECTION \_\_\_\_\_

Please indicate well location X.

ADDITIONAL INFORMATION

If more than one screen, show locations of each on sketch.