

**MARSHALL**  
**Q3**  
**10-5-72**

MISSISSIPPI  
 BOARD OF WATER COMMISSIONERS  
 416 North State Street  
 Jackson, Mississippi 39201

WATER WELL DRILLERS LOG

**CODED**  
*Marshall*

10-5-1972 date well completed  
 Deant West Burger water firm name  
 Marshall county well located

LANDOWNER:	description of formations encountered	from	to
J. T. Bowen			
Patte Comp Miss. (mailing address)	Sand	20	25

WELL LOCATION:  
 sec. 22 4 N. R. 1 E.  
 (S) (W)  
 1.7 miles S.E. of Holly Springs  
 (distance) (direction) (nearest town)

WELL PURPOSE: Drinking  
 (home, irrigation, municipal, industrial)

- WELL COMPLETION DATA:
- (1) diameter (inches) 4"
  - (2) total depth (feet) 25 feet
  - (3) static water level (feet) 53 feet below above top of ground.
  - (4) casing 4" PVC (material), 25 feet (depth)
  - (size) if telescope see back.
  - (5) screen 10 feet (length), 25 feet (depth to top)
  - 4" (size), gravel wall (material)
  - (6) pump 3/4 (HP), 1.4 (yield gpm)
  - (type power)
  - (7) electric log Elect (yes or no)
  - (organization running log)
  - (8) how well bottom plugged 4" Coff.

**CODED**


NOV - 9 1972

DRILLERS REMARKS:

MISSISSIPPI  
 BOARD OF WATER COMMISSIONERS  
 LABORATORY

If well telescopes please sketch and show depths.

GROUND LEVEL

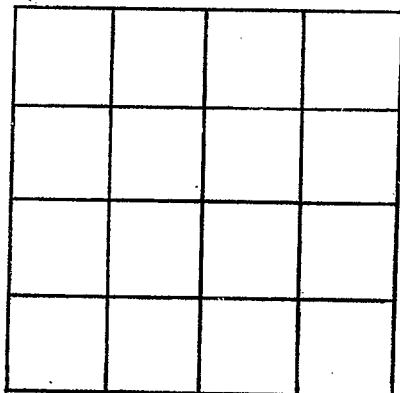

SECTION \_\_\_\_\_

Please indicate well location X.

ADDITIONAL INFORMATION

If more than one screen, show locations of each on sketch.