

MARSHALL  
# 2000  
3-6-80  
3-6

MISSISSIPPI  
BOARD OF WATER COMMISSIONERS  
416 North State Street  
Jackson, Mississippi 39201

WATER WELL DRILLERS LOG

date well completed 1980 firm name Nichols Well Co. county well located Marshall


LANDOWNER:		description of formations encountered	from	to
(mailing address)				
Brent Nichols		Clay	0	20
Holly Springs Miss		red sand	20	110
(distance) (direction) (nearest town)		white sand	110	185
WELL LOCATION:				
sec. 6 T. 4 N. R. 1 E. 3 miles E of Holly Springs				
WELL PURPOSE:				
(home, irrigation, municipal, industrial)				
WELL COMPLETION DATA:				
(1) diameter (inches) 4 in				
(2) total depth (feet) 185				
(3) static water level (feet) 100 below top of ground.				
(4) casing Plastic 185 (material) (depth)				
(size) If telescope see back.				
(5) screen 7 ft 178 (length) (depth to top)				
4 in Gravel (size) (material)				
(6) pump 1/2 10 (HP) (yield gpm)				
220 (type power)				
(7) electric log No (yes or no)				
(organization running log)				
(8) how well bottom plugged Cop				
DRILLERS REMARKS:				

DEPT. OF NATURAL RESOURCES  
BUREAU OF LAND & WATER RESOURCES

APR - 9 1980  
RECEIVED

If well telescopes please  
sketch and show depths.

GROUND LEVEL

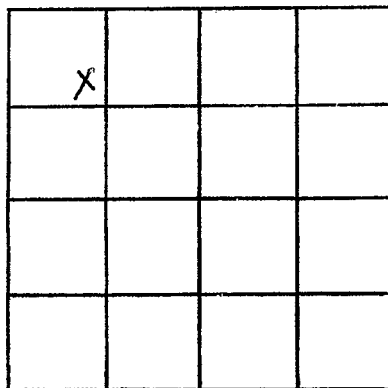

SECTION 6

Please indicate well location X.

ADDITIONAL INFORMATION

If more than one screen,  
show locations of each on sketch.