

MISSISSIPPI DEPARTMENT OF NATURAL RESOURCES

Bureau of Land and Water Resources

Southport Mall

P.O. Box 10631

Jackson, Mississippi 39209

WATER WELL DRILLERS LOG

MARSHAL
Q 2001
12-4-80
12-4-80

date well completed

firm name

county well located

Wilson Well Co Marshall

LANDOWNER: Joseph Lawson
210 W. Johnson Park
Holly Springs, Miss
(mailing address)

description of formations encountered

from

to

Red Clay Red-Sand	0	30
Red sand & Blue Clay	30	60
Blue Clay	60	330
Grey-Sand	330	335
Blue Clay	335	450
Rock	450	451
Blue Clay	451	774
Grey-Sand	774	830
Blue Clay	830	850
Rock + Blue Clay	850	865
Blue Clay	865	910

WELL LOCATION:

sec. 23 T 4 N R 1 E
(S) (W)
3 miles N of Potts Camp
(distance) (direction) (nearest town)

WELL PURPOSE: Home
(home, irrigation, municipal, industrial)

WELL COMPLETION DATA:

- (1) diameter (inches) 4
- (2) total depth (feet) 870
- (3) static water level (feet) 160 below top of ground.
- (4) casing Plastic
(material) (depth)
- 4"
(size) if telescope see back.
- (5) screen 80'
(length) (depth to top)
- 2" gravel packed
(size) (material)
- (6) pump 1 15
(HP) (yield gpm)
- electric
(type power)
- (7) electric log (yes or no)
- (organization running log)
- (8) how well bottom plugged 2"
plastic cap


DRILLERS REMARKS:

DEPT. OF NATURAL RESOURCES
BUREAU OF LAND & WATER RESOURCES

DEC 23 1980
RECEIVED

If well telescopes please
sketch and show depths.

GROUND LEVEL

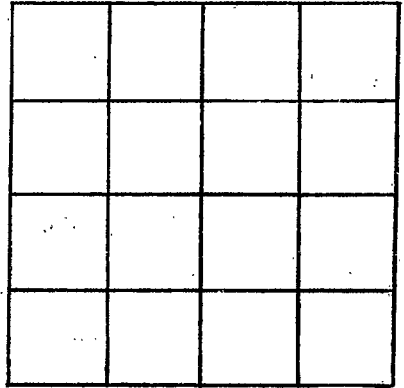

SECTION _____

Please indicate well location X.

ADDITIONAL INFORMATION

If more than one screen,
show locations of each on sketch.