

Marshall
 R3
 4-24-68

MISSISSIPPI
 BOARD OF WATER COMMISSIONERS
 416 North State Street
 Jackson, Mississippi 39201

CODED

WATER WELL DRILLERS LOG

April 24 1968 R. L. Carpenter Marshall
 date well completed firm name county well located

LANDOWNER: Lloyd Conrad
Laws Hill, Miss.
 (mailing address)

WELL LOCATION:
 sec. 12 T. 5 N R. 4 E
 S W
3 1/2 miles East of Chalahoma
 (distance) (direction) (nearest town)


WELL PURPOSE: Home
 (home, irrigation, municipal, industrial)

WELL COMPLETION DATA:

- (1) diameter (inches) 4
- (2) total depth (feet) 260
- (3) static water level (feet) 15.3 below top of ground.
- (4) casing Plastic, 254
 (material) (depth)
 (size) if telescope see back.
- (5) screen 6 ft., 254
 (length) (depth to top)
4 in., Plastic Thread
 (size) (material)
- (6) pump 3/4 12
 (HP) (yield gpm)
Elec.
 (type power).
- (7) electric log no.
 (yes or no)
 (organization running log)
- (8) how well bottom plugged Plastic Plug

description of formations encountered	from	to
<u>Surface Soil</u>	<u>0</u>	<u>9</u>
<u>white clay</u>	<u>9</u>	<u>18</u>
<u>Med. Red Sand</u>	<u>18</u>	<u>54</u>
<u>white coarse sand</u>	<u>54</u>	<u>70</u>
<u>white clay</u>	<u>70</u>	<u>82</u>
<u>Med. white sand</u>	<u>82</u>	<u>130</u>
<u>white clay</u>	<u>130</u>	<u>137</u>
<u>white clay + fine sand</u>	<u>137</u>	<u>168</u>
<u>white fine sand</u>	<u>168</u>	<u>240</u>
<u>white medium + coarse sand</u>	<u>240</u>	<u>260</u>

CODED

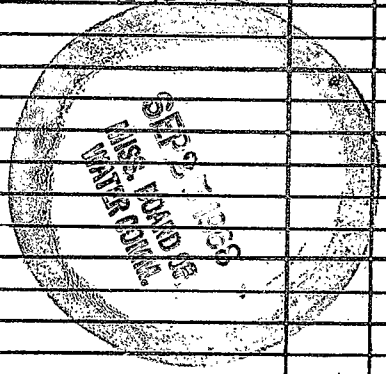


DRILLERS REMARKS:

If well telescopes please sketch and show depths.

GROUND LEVEL

R4W

755

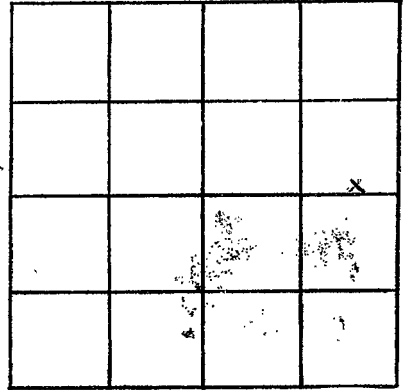

SECTION 12

Please indicate well location X.

ADDITIONAL INFORMATION

If more than one screen, show locations of each on sketch.