

Marshall  
 RA  
 5-5-68

MISSISSIPPI  
 BOARD OF WATER COMMISSIONERS  
 416 North State Street  
 Jackson, Mississippi 39201

**CODED**

WATER WELL DRILLERS LOG

May 5 1968 Red L. Carpenter Marshall  
 date well completed firm name county well located

LANDOWNER: Tom Lacy  
 Holly Springs,  
 Miss.  
 (mailing address)

description of formations encountered	from	to
Surface Soil	0	14
Med. Red Sand	14	47
Med. Red & white sand	47	73
Fine white sand	73	131
White coarse sand	131	200
White fine sand	200	242
White coarse sand	242	253
White fine & med. sand	253	264
White coarse sand	264	295

WELL LOCATION:  
 sec. 14 T 5 N R 4 E  
 S W  
 2 1/2 miles East of Chalahoma  
 (distance) (direction) (nearest town)

WELL PURPOSE: Farm  
 (home, irrigation, municipal, industrial)

WELL COMPLETION DATA:

(1) diameter (inches) 4

(2) total depth (feet) 295

(3) static water level (feet) 163 below top of ground.

(4) casing Plastic, 289  
 (material) (depth)

\_\_\_\_\_ if telescope see back.  
 (size)

(5) screen 6 Ft., 289  
 (length) (depth to top)

4 in. Plastic & thread  
 (size) (material)

(6) pump 3/4 12  
 (HP) (yield gpm)


Elec  
 (type power)

(7) electric log no  
 (yes or no)

\_\_\_\_\_ (organization running log)

(8) how well bottom plugged Plastic Plug

**CODED**

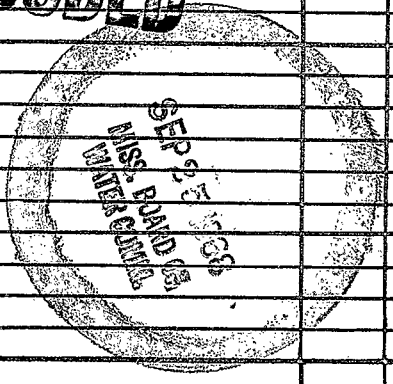


DRILLERS REMARKS:

If well telescopes please sketch and show depths.

GROUND LEVEL

R 4 W

T55

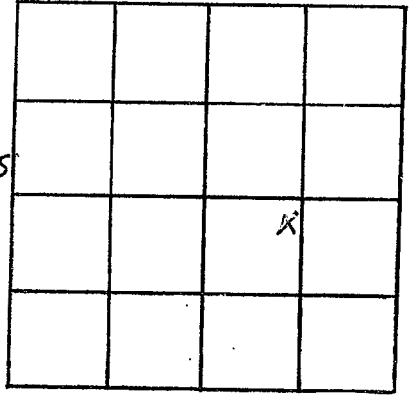

SECTION 14

Please indicate well location X.

ADDITIONAL INFORMATION

If more than one screen, show locations of each on sketch.