

MARSHALL
R 5
1-17-72

MISSISSIPPI
 BOARD OF WATER COMMISSIONERS
 416 North State Street
 Jackson, Mississippi 39201

WATER WELL DRILLERS LOG **CODED**

1/17/72 19 G. and H. Well Company Marshall
 date well completed firm name county well located

LANDOWNER:	description of formations encountered	from	to
Jimmy Algee			
Route 5, Holly Springs, Missi	Red Clay	1	15
(mailing address)	Red Sand Clay	15	20
	Red Sand Clay	20	30
WELL LOCATION:	Clay	30	40
sec. 18 T 5 N R 4 E	Caly	40	50
17 miles West of Holly Springs,	Clay	50	60
(distance) (direction) (nearest town)	Sandy Clay	60	70
WELL PURPOSE: Home	Sandy Clay	70	80
(home, irrigation, municipal, industrial)	Sandy Clay	80	90
WELL COMPLETION DATA:	Sandy Clay	90	100
(1) diameter (inches) 4 inch	White Sand	100	110
(2) total depth (feet) 185	White Sand x	110	120
(3) static water level (feet) 110 below top of ground.	White Sand	130	140
(4) casing Plastic 185 (material) (depth)	White Sand	140	150
(size) If telescope see back.	White Sand	150	160
(5) screen 5 ft. 180 ft. (length) (depth to top)	White Sand	160	170
4 in. Gravel (size) (material)	White Sand	170	180
(6) pump 3/4 10 GPM (HP) (yield gpm)	White Sand	180	185
Electric 220 (type power)			
(7) electric log No (yes or no)			
(organization running log)			
(8) how well bottom plugged Cap			
DRILLERS REMARKS:			


CODED

JAN 28 1972

MISS. BD. OF
 WATER COMM.

If well telescopes please sketch and show depths.

GROUND LEVEL

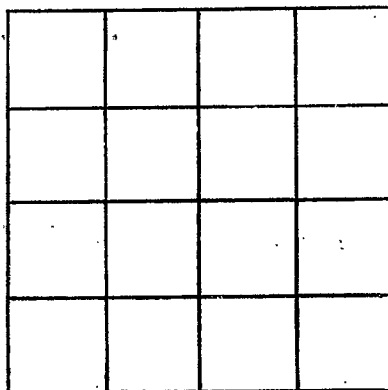

SECTION _____

Please indicate well location X.

ADDITIONAL INFORMATION

If more than one screen,
show locations of each on sketch.