

**MARSHALL**  
**R7**  
**4-72**

MISSISSIPPI  
 BOARD OF WATER COMMISSIONERS  
 416 North State Street  
 Jackson, Mississippi 39201

**CODED**

**WATER WELL DRILLERS LOG**

*Alberson & Frost Marshall*

date well completed \_\_\_\_\_ 19 \_\_\_\_\_ firm name \_\_\_\_\_ county well located \_\_\_\_\_

| LANDOWNER:   | description of formations encountered                                      | from  | to  |
|--|--|---|---|
| <i>Ernest Wilkins</i>  |  |   |   |
| <i>Chulahoma Miss</i><br>(mailing address)   | <i>rust</i><br><i>white sand</i><br><i>white clay</i><br><i>white sand</i> | <i>0</i><br><i>15</i><br><i>45</i><br><i>75</i> | <i>15</i><br><i>45</i><br><i>75</i><br><i>160</i> |
| WELL LOCATION:   |  |   |   |
| sec. <i>4</i> T <i>5</i> N R <i>4</i> E<br><i>1/2</i> miles <i>NE</i> of <i>Chulahoma</i><br>(distance) (direction) (nearest town) |  |   |   |
| WELL PURPOSE: <i>Home</i><br>(home, irrigation, municipal, industrial)   |  |   |   |
| WELL COMPLETION DATA:  |  |   |   |
| (1) diameter (inches) <i>4"</i>  |  |   |   |
| (2) total depth (feet) <i>160</i>  |  |   |   |
| (3) static water level (feet) <i>130</i> below top of ground.  |  |   |   |
| (4) casing <i>P.V.C.</i> , <i>160</i> ,<br>(material) (depth)  |  |   |   |
| _____ (size) if telescope see back.  |  |   |   |
| (5) screen <i>10'</i> , <i>150</i><br>(length) (depth to top)  |  |   |   |
| <i>4"</i> , <i>P.V.C.</i><br>(size) (material)   |  |   |   |
| (6) pump <i>3/4</i> , <i>10</i><br>(HP) (yield gpm)  |  |   |   |
| <i>elec.</i><br>(type power)   |  |   |   |
| (7) electric log <i>no</i><br>(yes or no)  |  |   |   |
| _____ (organization running log)   |  |   |   |
| (8) how well bottom plugged <i>C.A.P.</i>  |  |   |   |
| DRILLERS REMARKS:  |  |   |   |


**CODED**

APR 12 1972

MISS. Bd. OF  
 WATER COMM.

If well telescopes please sketch and show depths.

GROUND LEVEL

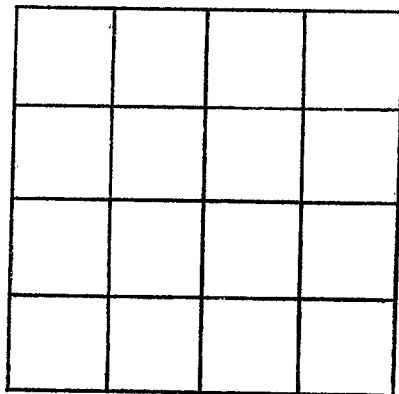

SECTION \_\_\_\_\_

Please indicate well location X.

ADDITIONAL INFORMATION

If more than one screen,  
show locations of each on sketch.