

MARSHALL
R8
4-4-72

MISSISSIPPI
 BOARD OF WATER COMMISSIONERS
 416 North State Street
 Jackson, Mississippi 39201

CODED

WATER WELL DRILLERS LOG

April 4 1972 Atkinson & Frost Marshall
 date well completed firm name county well located

LANDOWNER:
Weslington Burtov
Hally Spring, Miss
 (mailing address)

description of formations encountered	from	to
<u>red clay</u>	<u>0</u>	<u>20</u>
<u>red sand</u>	<u>20</u>	<u>120</u>
<u>white clay</u>	<u>120</u>	<u>130</u>
<u>white sand</u>	<u>130</u>	<u>160</u>

WELL LOCATION:
 sec. 4 T 5 N R 4 E
2 miles N of Chulahoma
 (distance) (direction) (nearest town)

WELL PURPOSE: Home
 (home, irrigation, municipal, industrial)

- WELL COMPLETION DATA:
- diameter (inches) 4"
 - total depth (feet) 160ft
 - static water level (feet) 130 below top of ground.
 - casing P.V.C., 130
 (material) (depth)
 (size) If telescope see back.
 - screen 10ft, 120'
 (length) (depth to top)
4", P.V.C.
 (size) (material)
 - pump 3/4, 10
 (HP) (yield gpm)
etc.
 (type power)
 - electric log ND
 (yes or no)
 (organization running log)
 - how well bottom plugged CAP.

CODED


APR 12 1972

MISS. WATER COM. 12

DRILLERS REMARKS:

If well telescopes please
sketch and show depths.

GROUND-LEVEL

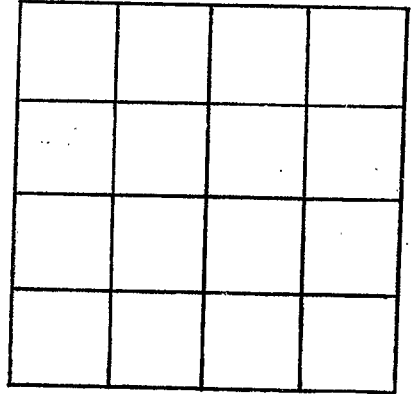

SECTION _____

Please indicate well location X.

ADDITIONAL INFORMATION

If more than one screen,
show locations of each on sketch.